

L 78

8-27-64

WATER WELL DRILLERS LOG

CODED

Date: AUG 27, 1964, Driller: DELTA DRILLING CO. County LEFLORE  
 (Name)

(1) Owner of Land: J. R. PARKERSON  
 (Name)

RTE. 2. GREENWOOD, MISS  
 (Address)

(2) Location: SE 1/4, SW 1/4, Sec. 1 T14N R15E  
 \_\_\_\_\_ miles \_\_\_\_\_ of \_\_\_\_\_  
 (distance) (direction) (Nearest Town)

(3) Topography: \_\_\_\_\_  
 (Hilly) (Flat) (Level)

(4) Purpose of Well: DOMESTIC  
 (Domestic Irrigation  
 Municipal, Industrial, Other)

Description & Color of Materials Sand, Clay, Red Clay, Shell, etc.	Thick- ness Feet	Depth Feet
GUMBO	30	30'
SAND	40	70'
GRAVEL	60	130'
SAND	42	172'
GUMBO W/ROCKS	78	250'
SHALE	46	296'
GUMBO W/ROCKS	33	329'
SAND	18	347'
GUMBO	46	393'
SHALE	10	403'
GUMBO	40	443'
SHALE CODED	60	503'
GUMBO	50	553'
SHALE	30	583'
GUMBO	29	612'
SAND	70	682'

Information upon completion of well:

(1) Diameter 4 inches.

(2) Total Depth 682 feet. *yield 40 GPM*

(3) Water Level FLOWS feet below top of ground.

(4) Cased to 662, Size 27 1/2" - 2"  
*63 1/2" - 4"*  
*33 7/8" - 3"*


(5) Screen: Size 2", Length 20'  
SS-D12GA

(6) Were any formations sealed against pollution?  
 \_\_\_\_\_ yes, \_\_\_\_\_ no.

If YES depth of formation \_\_\_\_\_

Why \_\_\_\_\_

Drillers Remarks: WELL FLOWS APPROXIMATELY 40 G.P.M.

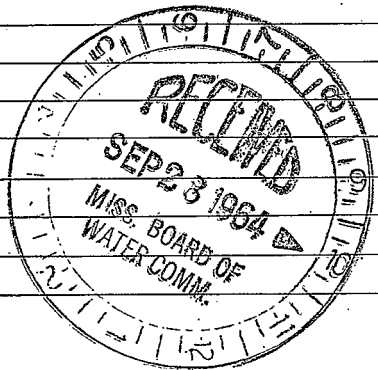

(Use Back Side)

Well No.









