

L82

9-16-60

WATER WELL DRILLERS LOG

CODED

Date: Sept. 16, 19 60, Driller: Layne-Central Company County Leflore

(Name)

Leflore County Board of Supervisors

(1) Owner of Land: _____
(Name)

Greenwood, Mississippi

(Address)

(2) Location: _____ $\frac{1}{4}$, _____ $\frac{1}{4}$, Sec. 12 T19N R2E

_____ miles east side of Greenwood
(distance) (direction) (Nearest Town)

(3) Topography: flat
(Hilly) (Flat) (Level)

(4) Purpose of Well: Irrigation
(Domestic Irrigation
Municipal, Industrial, Other)

Information upon completion of well:

(1) Diameter 8 inches.

(2) Total Depth 108 feet.

(3) Water Level 19 feet below top of ground.

(4) Cased to 79' 7", Size 8"

(5) Screen: Size 8", Length 30'

(6) Were any formations sealed against pollution?

_____ yes, X no.

If YES depth of formation _____

Why _____

Drillers Remarks: _____


Description & Color of Materials
Sand, Clay, Red Clay, Shell, etc.

Thick-
ness
Feet

Depth
Feet

Clay	34	34
Fine sand	18	52
Coarse sand	38	90
Coarse sand and pea gravel	18	108

CODED

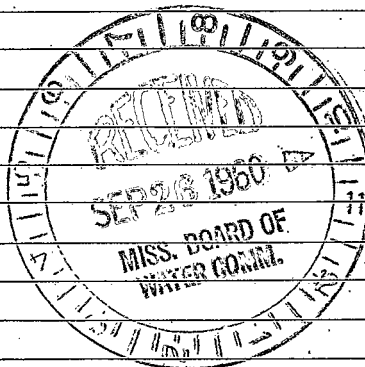

(Use Back Side)

Well No.



























