Lefhore
L193
6-22-63

MISSISSIPPI
BOARD OF WATER COMMISSIONERS Coded
416 North State Street
Jackson, Mississippi 39201

WATER WELL DRILLERS LOG

June 22 19 63 — date well completed
Delta Drilling Co. — firm name
Le Flore — county well located

LANDOWNER: G C Montjoy
Long Acres
Greenwood Miss
(mailing address)

WELL LOCATION:
sec. 28 T 19 N (S) R 1 E (W) N 1/4-N 1/4

(distance) miles (direction) of (nearest town)

WELL PURPOSE: Sub-Division
(home, irrigation, municipal, industrial)

WELL COMPLETION DATA:

(1) diameter (inches) 4"

(2) total depth (feet) 909'

(3) static water level (feet) Flows below above top of ground.

(4) casing Steel (material), 889 (depth),
500'-4" 410'-2½ (size) if telescope see back.

(5) screen 20' (length), (depth to top)
2½ (size), Stainless-Steel (material)

(6) pump (HP) (yield gpm)
Elec. (type power)

(7) electric log (yes or no)

(organization running log)

(8) how well bottom plugged

DRILLERS REMARKS: Well flows 80 GPM W/ 7# PSI. Shut in.

description of formations encountered	from	to
Sand	00	94
Gravel	94	161
Sand	289	289
Gumbo	289	349
Green Sand	349	446
Shale	440	480
Green Sand	480	510
Gumbo	510	528
Shale	528	570
Green Sand	570	586
Gumbo	586	612
Shale	612	674
Sand	674	752
Shale	752	820
Sand	828	909

If well telescopes please sketch and show depths.

GROUND LEVEL

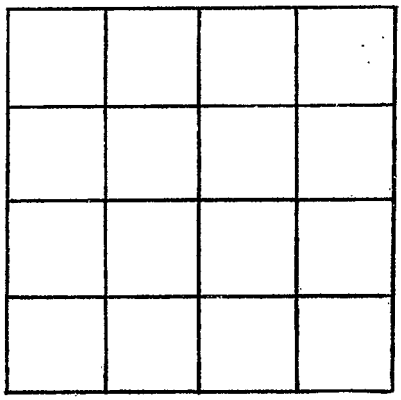

SECTION _____

Please indicate well location X.

ADDITIONAL INFORMATION

If more than one screen, show locations of each on sketch.