LeFLORE
L194
7-3-63

MISSISSIPPI
BOARD OF WATER COMMISSIONERS
416 North State Street
Jackson, Mississippi 39201

WATER WELL DRILLERS LOG

July 3 1963 — date well completed
Delta Drilling Co — firm name
LeFlore — county well located

LANDOWNER: P.L. McGinnis
McGinnis Sub-Div
Greenwood, Miss.
(mailing address)

WELL LOCATION:
sec. 24 T 19 N R 1 E

_____ miles _____ of _____
(distance) (direction) (nearest town)

WELL PURPOSE: Sub-Division
(home, irrigation, municipal, industrial)

WELL COMPLETION DATA:

(1) diameter (inches) 4"

(2) total depth (feet) 702'

(3) static water level (feet) Flows below above top of ground.

(4) casing 682' (material), _____ (depth),
4"-63'
3"-359'
2"-272'
(size) if telescope see back.

(5) screen 20 (length), _____ (depth to top)
2" (size), SS. Wire on Pipe (material)

(6) pump 1 1/2 (HP) 40 (yield gpm)
Electric (type power)

(7) electric log _____ (yes or no)

_____ (organization running log)

(8) how well bottom plugged 2" B.P.
VALVE

DRILLERS REMARKS: _____

description of formations encountered	from	to
Sand	00	65
Gravel	65	126
Sand	126	156
Gumbo	156	252
Shale	252	274
Sand	274	316
Shale	316	380
Gumbo w/ Rocks	380	442
Shale	442	462
Gumbo	462	545
Shale	545	563
Sand	563	583
Shale	583	613
Gumbo	613	632
Sand	632	702
	T.D.	

If well telescopes please sketch and show depths.

GROUND LEVEL

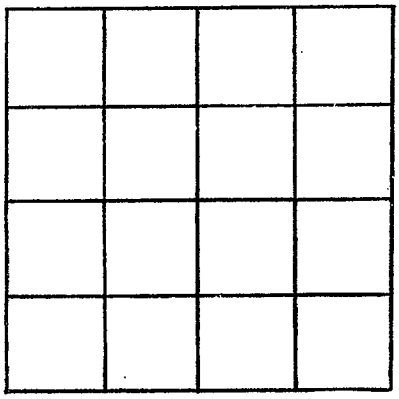

SECTION _____

Please indicate well location X.

ADDITIONAL INFORMATION

If more than one screen, show locations of each on sketch.