MISSISSIPPI DEPARTMENT OF NATURAL RESOURCES

Bureau of Land and Water Resources

P.O. Box 10631
Jackson, Mississippi 39209

WATER WELL DRILLERS LOG

1499

COUNTY WELL LOCATED: Leflore	
WELL NUMBER: L260	CODED: ✓
PERMIT NUMBER: 03835-CMG-060788	
DATE WELL COMPLETED: 3/28/88	NAME OF DRILLING FIRM: SUTANE GAS CO. OF GREENWOOD

NAME & MAILING ADDRESS OF LANDOWNER
Travelers Ins. Co.
Jackson, Miss

WELL LOCATION; SEC NE¼ of NE¼ 25 TOWNSHIP 19 N RANGE 1 E

DISTANCE 2½ Miles DIRECTION SE NEAREST TOWN of Greenwood

OTHER LANDMARK

WELL PURPOSE: Home, Irrigation, Municipal, Industrial, Fish Pond, etc.

PUMP DATA

PUMP TYPE (Circle One): Submersible, (Turbine), Jet, Flowing Well, Other (Describe)

POWER TYPE (Circle One): Electric, Tractor, (Diesel), Gasoline, Butane, Other (Describe)

Pump Capacity (GPM)	No. of Stages	Setting Depth
1300	3	60 FT.

PUMP TEST

Well yielded _____ GPM with a drawdown of _____ ft. after _____ hours of pumping

WELL DATA

Well Depth	Casing Diameter (In.)	Casing Length (Ft.)
110	16	70

Type of Casing	Hole Depth	Depth to Static Water Level
Steel	110	

TYPE OF COMPLETION: (Circle One or More): (Gravel Packed), Underreamed, Telescoped, Natural Development, Open Hole, Other (Describe)

Top of Lap Pipe or Reduction in Casing FEET

IF TELESCOPED OR MORE THAN ONE SCREEN: USE BACK PAGE

LOG DATA

TYPE OF LOG RUN (Circle One): (No Log Run), Electric, Gamma Ray, Density, Sonic, Neutron, Other (Describe)

Name of Organization Running Log

GEOLOGIC DATA (Office Use Only)

Surface Elev.	Geologic Unit	Unit Thickness	Depth to Top
Subs. SWL	Date	Analysis	Aquifer Test

Driller's Remarks

SCREEN DATA

Diameter - Inches	Length - Feet	Slot Size - Inches
16	40	.030

Screen Type	Depth to Bottom - Feet
Wire Wrapped	110

RECEIVED
APR 18 1988
Department of Natural Resources
Bureau of Land & Water Resources

DESCRIPTION OF FORMATIONS ENCOUNTERED	FROM	TO
Clay	0	20
Sand	20	30
Sand & Gravel	30	110

FORMATIONS (Continued)	FROM	TO

IF MORE SPACE IS NEEDED, USE BACK

If well telescopes please
sketch and show depths.

GROUND LEVEL

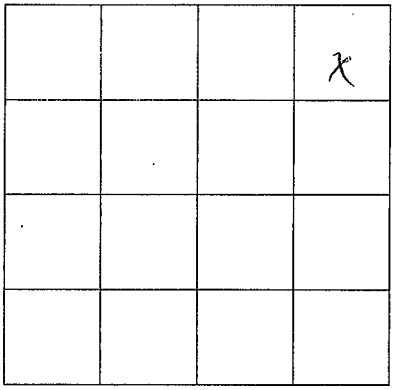

SECTION 2 1

Please indicate well location X.

ADDITIONAL INFORMATION

If more than one screen,
show location of each on sketch.