

Leflore MISSISSIPPI BOARD OF WATER COMMISSIONERS

L-1002

5-13-57

WATER WELL DRILLERS LOG

C 359

Date: May 13, , 19 57 , Driller: Layne-Central Company County Leflore

(Name)

(1) Owner of Land: Wildwood Plantation
(Name)

Greenwood, Mississippi
(Address)

(2) Location: 1/4, 1/4, Sec. T R

 miles , of Greenwood
(distance) (direction) (Nearest Town)

(3) Topography: flat
(Hilly) (Flat) (Level)

(4) Purpose of Well: irrigation
(Domestic Irrigation
Municipal, Industrial, Other)

Description & Color of Materials Sand, Clay, Red Clay, Shell, etc.	Thick- ness Feet	Depth Feet
Clay	18	18
Fine brown sand	8	26
Coarse blue sand	16	42
Coarse blue sand	10	52
Sand & pea rock	20	72
Sand & gravel	10	82
Sand & pea rock	20	102
Sand & gravel	6	108

Information upon completion of well:

(1) Diameter 12x12 inches.

(2) Total Depth 108 feet.

(3) Water Level 23' - 5" feet below top of ground.

(4) Cased to 68', Size 12"

(5) Screen: Size 12", Length 50'

(6) Were any formations sealed against pollution?

 yes, no no.


If YES depth of formation

Why

Drillers Remarks:

1200 GPM

engine drive

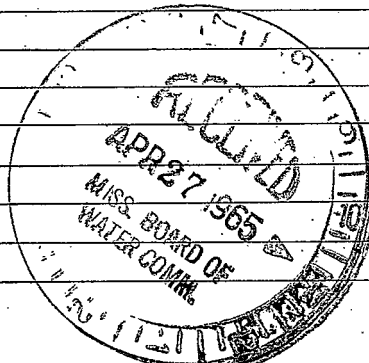

(Use Back Side)

Well No.





[Signature]