Leflore
L 7013
6-13-77

MISSISSIPPI
BOARD OF WATER COMMISSIONERS
416 North State Street
Jackson, Mississippi 39201

WATER WELL DRILLERS LOG

6-13-77 19 BUTANE GAS CO. OF GREENWOOD Leflore
date well completed — firm name — county well located

LANDOWNER:
MRS. Nettie M. Motley
Greenwood
(mailing address)

WELL LOCATION:
sec. 1 T. 19 (N) (S) R. 1 (E) (W)
1 (distance) miles NE (direction) of Greenwood (nearest town)

WELL PURPOSE: Home
(home, irrigation, municipal, industrial)

WELL COMPLETION DATA:

(1) diameter (inches) 8"
(2) total depth (feet) 304
(3) static water level (feet) 1 (below) above top of ground.
(4) casing Steel (material), 294 (depth), 2" (size) if telescope see back.
(5) screen 10' (length), 294 (depth to top), 2" (size), Stainless (material)
(6) pump 1/3 (HP) 10 (yield gpm)
Elec. (type power)
(7) electric log No (yes or no)
(organization running log)
(8) how well bottom plugged Back Pressure Valve

DRILLERS REMARKS:

description of formations encountered	from	to
Clay	0	30
Sand	30	60
Sand & Gravel	60	120
Sand & Clay	120	220
Shale & Clay	220	290
Sand	290	315

RECEIVED
JUN 13 1977
MISS. BD. OF WATER COMM

If well telescopes please sketch and show depths.

GROUND LEVEL

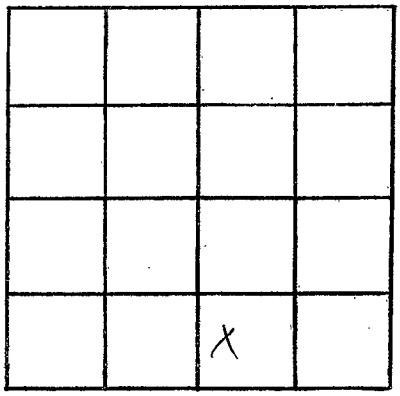

SECTION 1

Please indicate well location X.

ADDITIONAL INFORMATION

If more than one screen, show locations of each on sketch.