LEFLORE
N 26
6-20-73

MISSISSIPPI BOARD OF WATER COMMISSIONERS
416 North State Street
Jackson, Mississippi 39201

CODED

WATER WELL DRILLERS LOG

BUTANE GAS CO. OF GREENWOOD

6-20-73 19 — date well completed
firm name
Leflore — county well located

LANDOWNER: Loyce MAKamson
Sidon
(mailing address)

WELL LOCATION:
sec. 33 T 17 N R 1 W
2½ miles E of MORGAN CITY
(distance) (direction) (nearest town)

WELL PURPOSE: Home
(home, irrigation, municipal, industrial)

WELL COMPLETION DATA:

(1) diameter (inches) 4X2
(2) total depth (feet) 1164
(3) static water level (feet) 30 ~~below~~ above top of ground.
(4) casing Steel (material), 1134 (depth), 4X2 (size) if telescope see back.
(5) screen 30 (length), 1134 (depth to top), 2" (size), Stainless (material)
(6) pump ____ (HP) 35 (yield gpm)
____ (type power)
(7) electric log ____ (yes or no)
____ (organization running log)
(8) how well bottom plugged Lead Plug

DRILLERS REMARKS:

description of formations encountered	from	to
Clay	0	10
Sand	10	60
Sand + Gravel	60	130
Sand	130	150
Clay	150	230
Sand	230	470
Clay	470	550
Sand, Shale, Rock	550	940
Clay	940	970
Shale	970	1100
Sand	1100	1164

CODED

JUN 26 1973

If well telescopes please sketch and show depths.

GROUND LEVEL

105' - 4" CASING

1029' - 2" CASING

30' - 2" SCREEN

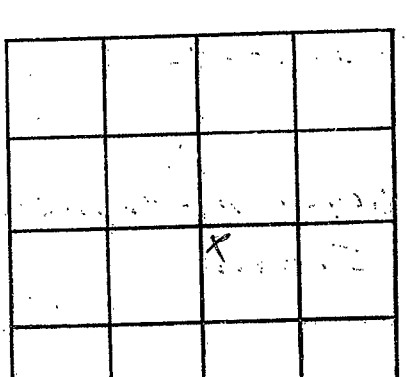

SECTION 33

Please indicate well location X.

ADDITIONAL INFORMATION

If more than one screen, show locations of each on sketch.