LeFlore
~~[illegible]~~ N31
1-16-75

MISSISSIPPI
BOARD OF WATER COMMISSIONERS
416 North State Street
Jackson, Mississippi 39201

CODED
087

WATER WELL DRILLERS LOG

1-16-75 19 — EXTANE GAS CO. OF GREENWOOD — Leflore
date well completed — firm name — county well located

LANDOWNER: David Hodges

ITTA BENA
(mailing address)

WELL LOCATION:
sec. 18 T 18 N & R 1 ~~E~~ W

3 (distance) miles SW (direction) of Quito (nearest town)

WELL PURPOSE: Home
(home, irrigation, municipal, industrial)

WELL COMPLETION DATA:

(1) diameter (inches) 4 X 2

(2) total depth (feet) 1101

(3) static water level (feet) 20 ~~below~~ above top of ground.

(4) casing Steel (material), 1071 (depth),
4 X 2 (size) if telescope see back.

(5) screen 30' (length), 1071 (depth to top)
2" (size), Stainless (material)

(6) pump dun (HP) 30 (yield gpm)
None (type power)

(7) electric log _____ (yes or no)
_____ (organization running log)

(8) how well bottom plugged Lead Plug

DRILLERS REMARKS:

description of formations encountered	from	to
Clay	0	10
Sand	10	60
Sand + Gravel	60	130
Sand	130	360
Green Sand	360	480
Clay	480	530
Shale + Sand	530	710
Sand	710	950
Shale	950	950
Clay	950	1015
Sand	1015	1101

CODED

RECEIVED
JAN 21 1975
MISSISSIPPI BOARD OF WATER COMMISSIONERS

If well telescopes please sketch and show depths.

GROUND LEVEL

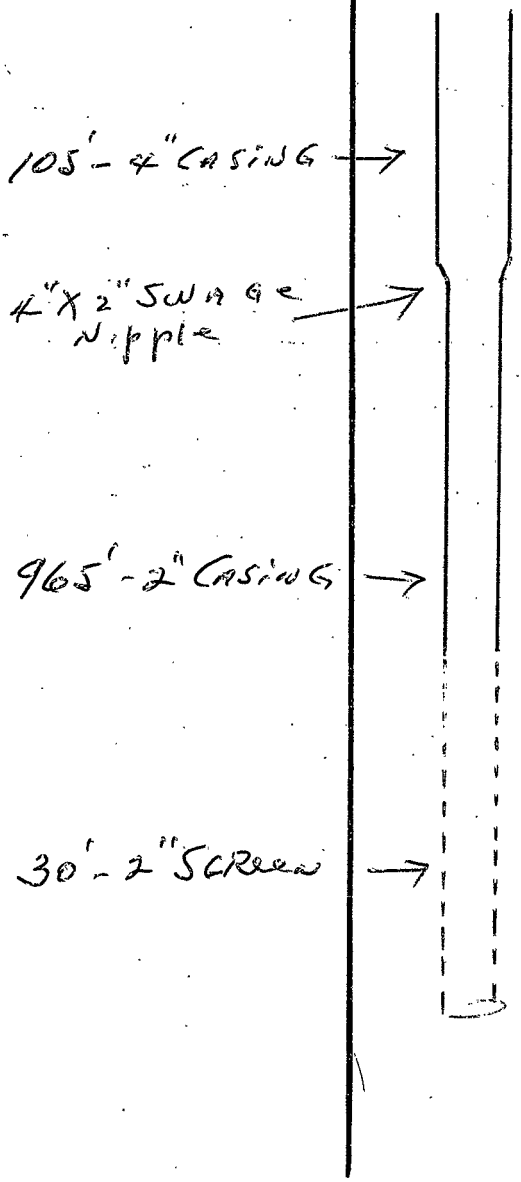

If more than one screen, show locations of each on sketch.

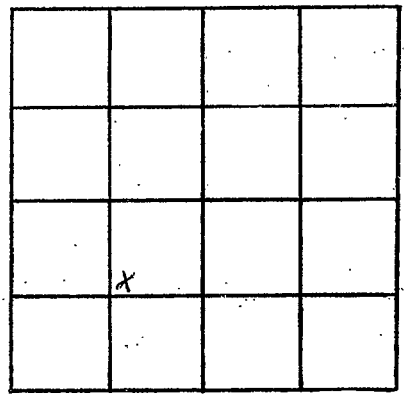

SECTION 18

Please indicate well location X.

ADDITIONAL INFORMATION