Lefore
N 55
4-2-81

MISSISSIPPI DEPARTMENT OF NATURAL RESOURCES

Bureau of Land and Water Resources
Southport Mall
P.O. Box 10631
Jackson, Mississippi 39209

CODED

WATER WELL DRILLERS LOG

4-2-81 19 — date well completed

BUTANE GAS CO. OF GREENWOOD — firm name

Leflore — county well located

LANDOWNER:
LAMAR MATHENSON
S. Dow
(mailing address)

WELL LOCATION:
sec. 27 T 18 N & R 1 E & W.
5 miles (distance) SW (direction) of S. Dow (nearest town)

WELL PURPOSE: Home
(home, irrigation, municipal, industrial)

WELL COMPLETION DATA:

(1) diameter (inches) 4 X 2
(2) total depth (feet) 660
(3) static water level (feet) 5 ~~below~~ above top of ground.
(4) casing Steel (material), 1630 (depth), 4 X 2 (size) if telescope see back.
(5) screen 30 (length), 630 (depth to top), 2" (size), Stainless (material)
(6) pump 2 (HP) 30 (yield gpm) Elec (type power)
(7) electric log No (yes or no)
(organization running log)
(8) how well bottom plugged Back Pressure Valve

DRILLERS REMARKS:

description of formations encountered	from	to
~~Sand~~ Clay	0	20
Sand	20	80
Gravel	80	150
Clay	150	175
Sand	175	360
Sandy Shale	360	550
Fine Sand	550	610
Coarse Sand	610	660

CODED
APR 1981
RECEIVED

If well telescopes please sketch and show depths.

GROUND LEVEL

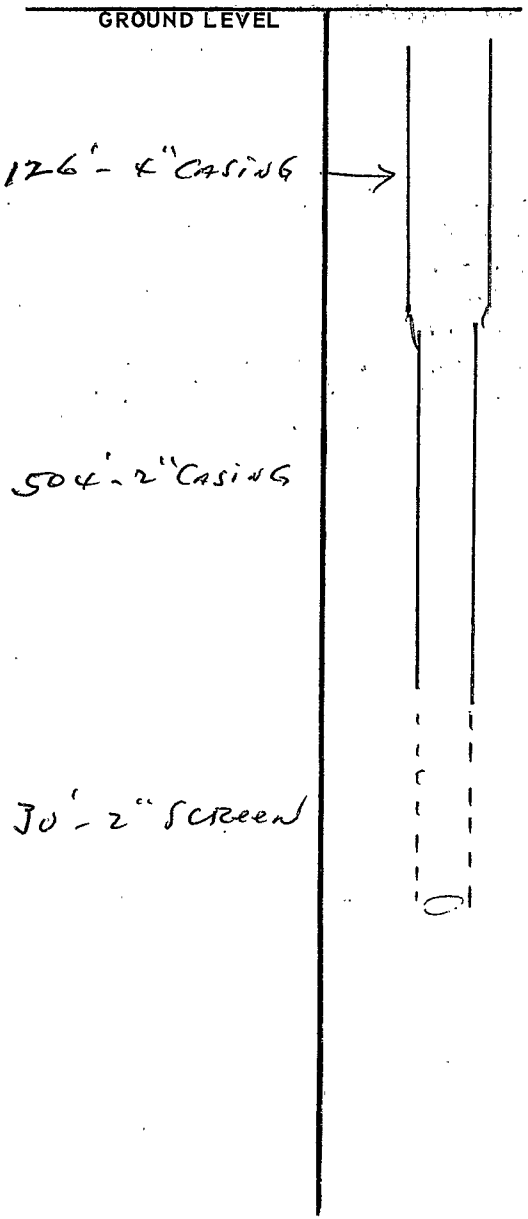

If more than one screen, show locations of each on sketch.

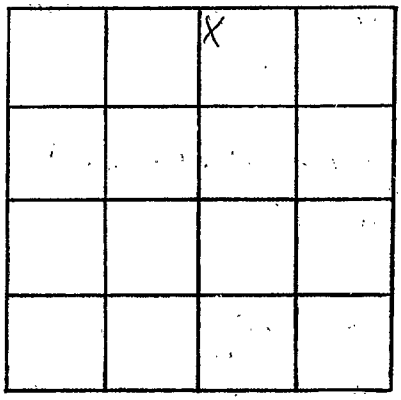

SECTION 27

Please indicate well location X.

ADDITIONAL INFORMATION