MISSISSIPPI DEPARTMENT OF NATURAL RESOURCES

Bureau of Land and Water Resources

P.O. Box 10631
Jackson, Mississippi 39209

WATER WELL DRILLERS LOG

COUNTY WELL LOCATED: Leflore	
WELL NUMBER: N 20	CODED: 11
DATE WELL COMPLETED: 12-19-90	
PERMIT NUMBER:	
NAME OF DRILLING FIRM: Butane Gas Co.	

NAME & MAILING ADDRESS OF LANDOWNER
Fred Poindexter
Morgan City, Miss.

WELL LOCATION: SEC 31 TOWNSHIP 18 N RANGE 1 W

DISTANCE 1 Miles DIRECTION E. NEAREST TOWN of Morgan City

OTHER LANDMARK

WELL PURPOSE: Home, Irrigation, Municipal, Industrial, Fish Pond, etc.
Irrigation

PUMP DATA

PUMP TYPE (Circle One): Submersible, Turbine, Jet, Flowing Well, Other (Describe)

POWER TYPE (Circle One): Electric, Tractor, Diesel, Gasoline, Butane, Other (Describe) H/P 10

Pump Capacity (GPM)	No. of Stages	Setting Depth
600	1	60 FT.

PUMP TEST

Well yielded _____ GPM with a drawdown of _____ ft. after _____ hours of pumping

WELL DATA

Well Depth	Casing Diameter (In.)	Casing Length (Ft.)
104	10	64

Type of Casing	Hole Depth	Depth to Static Water Level
PVC	110	27

TYPE OF COMPLETION: (Circle One or More): Gravel Packed, Underreamed, Telescoped, Natural Development, Open Hole, Other (Describe)

Top of Lap Pipe or Reduction in Casing FEET

IF TELESCOPED OR MORE THAN ONE SCREEN: USE BACK PAGE

LOG DATA

TYPE OF LOG RUN (Circle One): No Log Run, Electric, Gamma Ray, Density, Sonic, Neutron, Other (Describe)

Name of Organization Running Log

GEOLOGIC DATA (Office Use Only)

Surface Elev.	Geologic Unit	Unit Thickness	Depth to Top
Subs. SWL	Date	Analysis	Aquifer Test

Driller's Remarks

SCREEN DATA

Diameter - Inches	Length - Feet	Slot Size - Inches
10	40	.040

Screen Type	Depth to Bottom - Feet
PVC	104

DESCRIPTION OF FORMATIONS ENCOUNTERED	FROM	TO
Top Soil	0	10
Clay & Fine Sand	10	20
Coarse Sand	20	30
Sand & Gravel	30	80
Large Gravel	80	110

FORMATIONS Continued	FROM	TO

IF MORE SPACE IS NEEDED, USE BACK

RECEIVED
JAN 16 1991
Dept. of Environmental Quality
Bureau of Land & Water Resources

If well telescopes please
sketch and show depths.

GROUND LEVEL

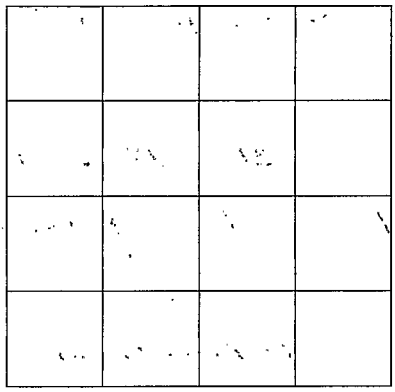

SECTION _____

Please indicate well location X.

ADDITIONAL INFORMATION

If more than one screen,
show location of each on sketch.