

LEFIORE  
P 36  
1-28-75

MISSISSIPPI  
BOARD OF WATER COMMISSIONERS  
416 North State Street  
Jackson, Mississippi 39201

INDEXED

WATER WELL DRILLERS LOG

1-28-75 19 EUTANE GAS CO. OF GREENWOOD Leflore  
date well completed firm name county well located

LANDOWNER:  
MARY Golden  
Swiftown  
(mailing address)

WELL LOCATION:  
sec. 21 T. 17 (N) R. 2 (W)  
1 miles N of Swiftown  
(distance) (direction) (nearest town)

WELL PURPOSE: Home  
(home, irrigation, municipal, industrial)

- WELL COMPLETION DATA:
- (1) diameter (inches) 4 X 2
  - (2) total depth (feet) 536
  - (3) static water level (feet) 12 below  
top of ground. above
  - (4) casing Steel, 526  
(material) (depth)  
4 X 2 If telescope see back.  
(size)
  - (5) screen 10', 526  
(length) (depth to top)  
2", Stainless  
(size) (material)
  - (6) pump 1/2, 10  
(HP) (yield gpm)  
Elec.  
(type power)
  - (7) electric log NO  
(yes or no)  
  
(organization running log)
  - (8) how well bottom plugged BACK  
PRESSURE VALVE

description of formations encountered	from to	
<u>Clay</u>	<u>0</u>	<u>18</u>
<u>Sand</u>	<u>18</u>	<u>25</u>
<u>GRAVEL</u>	<u>75</u>	<u>155</u>
<u>Siltstone</u>	<u>155</u>	<u>214</u>
<u>Sandy Siltstone</u>	<u>214</u>	<u>240</u>
<u>Siltstone</u>	<u>240</u>	<u>430</u>
<u>Sandstone streaks</u>	<u>430</u>	<u>495</u>
<u>SAND</u>	<u>495</u>	<u>560</u>
<u>CORNER</u>		

RECEIVED  
JAN 31 1975

MISS. BD. OF WATER COMMISSIONERS

DRILLERS REMARKS:

If well telescopes please sketch and show depths.


GROUND LEVEL

105'-4" CASING →

1'-4 X 2 SWAGG  
NIPPLE →

420'-2" CASING →

10'-2" SCREEN

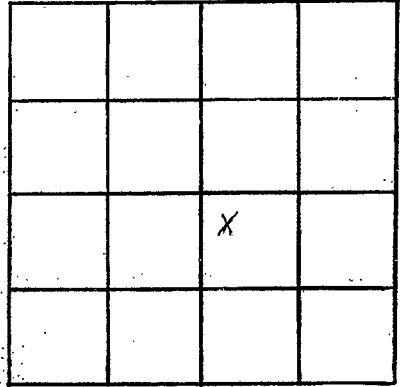

SECTION 21

Please indicate well location X.

ADDITIONAL INFORMATION

If more than one screen,  
show locations of each on sketch.