C

MISSISSIPPI DEPARTMENT OF NATURAL RESOURCES

Bureau of Land and Water Resources

P.O. Box 10631
Jackson, Mississippi 39209
WATER WELL DRILLERS LOG

COUNTY WELL LOCATED: LINCOLN

WELL NUMBER: A 2010 CODED

DATE WELL COMPLETED: 2-9-88

PERMIT NUMBER:

NAME OF DRILLING FIRM: GRENN WWELL

NAME & MAILING ADDRESS OF LANDOWNER: ROOSEVELT KELLY

WELL LOCATION: SEC 12 TOWNSHIP 8 (N) S RANGE 5 (E) W

DISTANCE 12 Miles DIRECTION NORTH WEST of NEAREST TOWN BROOKHAVEN

OTHER LANDMARK:

WELL PURPOSE: Home, Irrigation, Municipal, Industrial, Fish Pond, etc.: HOME

PUMP DATA

PUMP TYPE (Circle One): Submersible, Turbine, Jet, Flowing Well, Other (Describe) NO

POWER TYPE (Circle One): Electric, Tractor, Diesel, Gasoline, Butane, Other (Describe)

Pump Capacity (GPM)	No. of Stages	Setting Depth
		FT.

PUMP TEST

Well yielded 7 GPM with a drawdown of 0 ft. after 10 MIN hours of pumping

WELL DATA

Well Depth	Casing Diameter (In.)	Casing Length (Ft.)
147	4	135

Type of Casing	Hole Depth	Depth to Static Water Level
PVC	150	95

TYPE OF COMPLETION: (Circle One or More): Gravel Packed, Underreamed, Telescoped, Natural Development, Open Hole, Other (Describe)

Top of Lap Pipe or Reduction in Casing: FEET

IF TELESCOPED OR MORE THAN ONE SCREEN: USE BACK PAGE

LOG DATA

TYPE OF LOG RUN (Circle One): No Log Run, Electric, Gamma Ray, Density, Sonic, Neutron, Other (Describe)

Name of Organization Running Log

GEOLOGIC DATA (Office Use Only)

Surface Elev.	Geologic Unit	Unit Thickness	Depth to Top
Subs. SWL	Date	Analysis	Aquifer Test

Driller's Remarks

SCREEN DATA

Diameter - Inches	Length - Feet	Slot Size - Inches
4	10	010

Screen Type	Depth to Bottom - Feet
PVC	147

RECEIVED
APR 20 1988
Department of Natural Resources
Bureau of Land & Water Resources

DESCRIPTION OF FORMATIONS ENCOUNTERED	FROM	TO
CITRONELLE	1	150

FORMATIONS (continued)	FROM	TO

IF MORE SPACE IS NEEDED, USE BACK

If well telescopes please sketch and show depths.

GROUND LEVEL

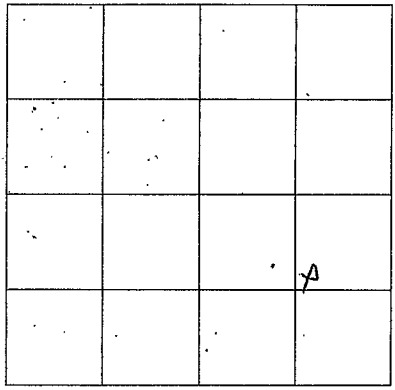

SECTION 12

Please indicate well location X.

ADDITIONAL INFORMATION

If more than one screen, show location of each on sketch.