LINCOLN
B 29
10-10-73

MISSISSIPPI
BOARD OF WATER COMMISSIONERS
416 North State Street
Jackson, Mississippi 39201

CODED

WATER WELL DRILLERS LOG

10 Oct. 1973 — Amos Parker Well Co. — Lincoln
date well completed — firm name — county well located

LANDOWNER: Home Homes
Brookhaven, Miss 39601
(mailing address)

WELL LOCATION:
sec 26 T 8 (N) S R 6 (E) W

_____ miles _____ of _____
(distance) (direction) (nearest town)

WELL PURPOSE: (home, irrigation, municipal, industrial)

WELL COMPLETION DATA:

(1) diameter (inches) 4
(2) total depth (feet) 181
(3) static water level (feet) 100 below above top of ground.
(4) casing Pl (material), 175 (depth),
_____ (size) if telescope see back.
(5) screen 6 (length), 175 (depth to top)
4 (size), Pl (material)
(6) pump ½ (HP) 8 (yield gpm)
Elect (type power)
(7) electric log _____ (yes or no)
_____ (organization running log)
(8) how well bottom plugged wood

DRILLERS REMARKS:

description of formations encountered	from	to
Clay	0	20
Clay	20	35
Sand & Clay	35	70
Sand	70	90
Clay	90	160
Sand	160	181

DEC 2 1973
MISS. GEOL. SURVEY

If well telescopes please sketch and show depths.

GROUND LEVEL

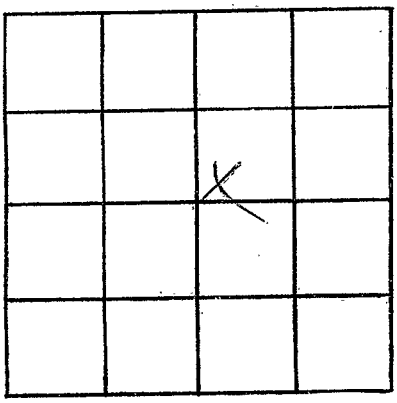

SECTION 26

Please indicate well location X.

ADDITIONAL INFORMATION

If more than one screen, show locations of each on sketch.