MISSISSIPPI DEPARTMENT OF NATURAL RESOURCES

Bureau of Land and Water Resources

P.O. Box 10631
Jackson, Mississippi 39209
WATER WELL DRILLERS LOG

COUNTY WELL LOCATED: Lincoln	
WELL NUMBER: D 2009	CODED
DATE WELL COMPLETED: 10-1-87	
PERMIT NUMBER:	
NAME OF DRILLING FIRM: Grenn Water Well & Supply	

NAME & MAILING ADDRESS OF LANDOWNER
Dale Leggett
Rt 2 Box 190
Wesson. Ms.

WELL LOCATION: SEC 17 TOWNSHIP 8 (N) S RANGE 8 (E) W

DISTANCE 7 Miles DIRECTION N.E. NEAREST TOWN of Brookhaven

OTHER LANDMARK

WELL PURPOSE: Home, Irrigation, Municipal, Industrial, Fish Pond, etc.
Home

PUMP DATA

PUMP TYPE (Circle One): (Submersible) Turbine, Jet Flowing Well, Other (Describe)

POWER TYPE (Circle One): (Electric) Tractor, Diesel, Gasoline, Butane, Other (Describe)

Pump Capacity (GPM)	No. of Stages	Setting Depth
10	10	65 FT.

PUMP TEST
Well yielded 10 GPM with a drawdown of 5 ft. after 10 min hours of pumping

WELL DATA

Well Depth	Casing Diameter (In.)	Casing Length (Ft.)
85	4	75

Type of Casing	Hole Depth	Depth to Static Water Level
PVC	90	40

TYPE OF COMPLETION: (Circle One or More): (Gravel Packed) Underreamed, Telescoped, Natural Development, Open Hole, Other (Describe)

Top of Lap Pipe or Reduction in Casing
FEET — IF TELESCOPED OR MORE THAN ONE SCREEN: USE BACK PAGE

SCREEN DATA

Diameter - Inches	Length - Feet	Slot Size - Inches
4	10	.010

Screen Type	Depth to Bottom - Feet
PVC	85

LOG DATA

TYPE OF LOG RUN (Circle One): (No Log Run) Electric, Gamma Ray, Density, Sonic, Neutron, Other (Describe)

Name of Organization Running Log

GEOLOGIC DATA (Office Use Only)

Surface Elev.	Geologic Unit	Unit Thickness	Depth to Top
Subs. SWL	Date	Analysis	Aquifer Test

Driller's Remarks

DESCRIPTION OF FORMATIONS ENCOUNTERED	FROM	TO
Clay	1	15
Sand & Gravel	15	22
White Clay	22	42
Blue Clay	42	78
Sand	78	85

FORMATIONS (Continued)	FROM	TO

RECEIVED
NOV 10 1987
Department of Natural Resources
Bureau of Land & Water Resources

IF MORE SPACE IS NEEDED, USE BACK

If well telescopes please
sketch and show depths.

GROUND LEVEL

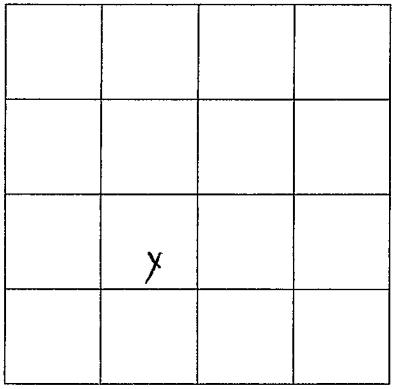

SECTION 17

Please indicate well location X.

ADDITIONAL INFORMATION

If more than one screen,
show location of each on sketch.