MISSISSIPPI DEPARTMENT OF ENVIRONMENTAL QUALITY
Office of Land and Water Resources

P. O. Box 10631
Jackson, MS 39289-0631

WATER WELL DRILLERS LOG

COUNTY WELL LOCATED: Lincoln	
WELL NUMBER: E-2016	CODED:
DATE WELL COMPLETED: 10-21-00	
PERMIT NUMBER: Grenn Water Well & Supply	
NAME OF DRILLING FIRM: Uncle Dr. SE, Bogue Chitto, MS 39629	

NAME & MAILING ADDRESS OF LANDOWNER
Robert Ladell + Fay Leggett
2779 Bahalia Rd NE
Wesson MS

WELL LOCATION	SEC	TOWNSHIP	RANGE
	19	8 (N) S	9 (E) W

DISTANCE	DIRECTION	NEAREST TOWN
7 Miles	NE	of Brookhaven

OTHER LANDMARK

WELL PURPOSE (Home) Irrigation, Municipal, Industrial, Fish Pond, etc.

PUMP DATA

PUMP TYPE (Circle One): Submersible, Turbine, Jet, Flowing Well, Other (Describe)

POWER TYPE (Circle One): Electric, Tractor, Diesel, Gasoline, Butane, Other (Describe) H/P 3/4 1/2

Pump Capacity (GPM)	No of Stages	Setting Depth
10	9	70 FT.

PUMP TEST
Well yielded 10 GPM with a drawdown of 0 ft. after 1 hours of pumping

WELL DATA

Well Depth	Casing Diameter (In.)	Casing Length (Ft.)
110	4	100

Type of Casing	Hole Depth	Depth to Static Water Level
PVC	120'	45

TYPE OF COMPLETION: (Circle One or More): Gravel Packed, Underreamed, Telescoped, Natural Development, Open Hole, Other (Describe)

WELL GROUTED TO A DEPTH OF 10 FEET
Type Grout (circle one): Cement, Bentonite, or Mix

LOG DATA

TYPE OF LOG RUN (Circle One): No Log Run, Electric, Gamma Ray, Density, Sonic, Neutron, Other (Describe)

Name of Organization Running Log

GEOLOGIC DATA (Office Use Only)

Surface Elev	Geologic Unit	Unit Thickness	Depth to Top
Subs SWL	Date	Analysis	Aquifer Test

Driller's Remarks

SCREEN DATA

Diameter - Inches	Length - Feet	Slot Size - Inches
4	10	.010

Screen Type	Depth to Bottom - Feet
PVC	110

Top of Lap Pipe or Reduction in Casing
FEET — IF TELESCOPED OR MORE THAN ONE SCREEN: USE BACK PAGE

DESCRIPTION OF FORMATIONS ENCOUNTERED	FROM	TO
Red Clay	0	80
Streaky	80	92
Sand	92	112
Blue Clay	112	120

FORMATIONS (Continued)	FROM	TO

RECEIVED MAR 19 2001 Dept. of Environmental Quality Office of Land & Water Resources

IF MORE SPACE IS NEEDED, USE BACK

If well telescopes please sketch and show depths.

GROUND LEVEL

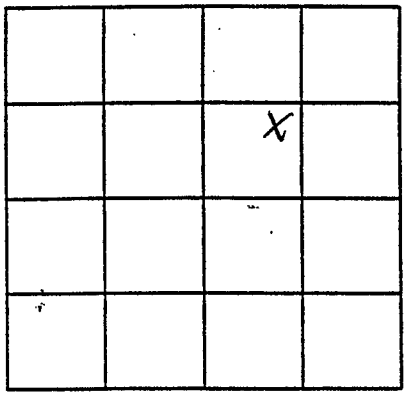

SECTION 19

Please indicate well location X.

ADDITIONAL INFORMATION

If more than one screen, show location of each on sketch.