MISSISSIPPI DEPARTMENT OF ENVIRONMENTAL QUALITY
Office of Land and Water Resources

P. O. Box 10631
Jackson, MS 39289-0631

WATER WELL DRILLERS LOG

COUNTY WELL LOCATED	
Lincoln	
WELL NUMBER F-2127	CODED
DATE WELL COMPLETED 10-06-00	

PERMIT NUMBER
Green Water Well & Supply
NAME OF DRILLING FIRM
Rosedale Dr. SE
Rogue Chito, MS 39629

NAME & MAILING ADDRESS OF LANDOWNER
Scott + Melanie Waller
854 Posey Dr NW
Brookhaven MS

WELL LOCATION	SEC	TOWNSHIP	RANGE
	28	7 N S	6 E W

DISTANCE	DIRECTION	NEAREST TOWN
7 Miles	West	of Brookhaven

OTHER LANDMARK

WELL PURPOSE Home, Irrigation, Municipal, Industrial, Fish Pond, etc.

PUMP DATA

PUMP TYPE (Circle One): Submersible, Turbine, Jet, Flowing Well, Other (Describe)

POWER TYPE (Circle One): Electric, Tractor, Diesel, Gasoline, Butane, Other (Describe) H/P

Pump Capacity (GPM)	No of Stages	Setting Depth
		FT.

PUMP TEST

Well yielded _____ GPM with a drawdown of _____ ft. after _____ hours of pumping

WELL DATA

Well Depth	Casing Diameter (In.)	Casing Length (Ft.)
182	4	172

Type of Casing	Hole Depth	Depth to Static Water Level
PVC	200	48

TYPE OF COMPLETION: (Circle One or More): Gravel Packed, Underreamed, Telescoped, Natural Development, Open Hole, Other (Describe)

WELL GROUTED TO A DEPTH OF 0 FEET
Type Grout (circle one): Cement, Bentonite, or Mix

LOG DATA

TYPE OF LOG RUN (Circle One): No Log Run, Electric, Gamma Ray, Density, Sonic, Neutron, Other (Describe)

Name of Organization Running Log

GEOLOGIC DATA (Office Use Only)

Surface Elev	Geologic Unit	Unit Thickness	Depth to Top
Subs SWL	Date	Analysis	Aquifer Test

Driller's Remarks

Top of Lap Pipe or Reduction in Casing FEET

IF TELESCOPED OR MORE THAN ONE SCREEN: USE BACK PAGE

SCREEN DATA

Diameter - Inches	Length - Feet	Slot Size - Inches
4	10	.010

Screen Type	Depth to Bottom - Feet
PVC	182

DESCRIPTION OF FORMATIONS ENCOUNTERED	FROM	TO
Red Clay	0	12
Sand + Gravel	12	48
White Clay	48	60
Blue Clay	60	117
Sand	117	200

FORMATIONS (Continued)	FROM	TO

RECEIVED
MAR 19 2001
Dept. of Environmental Quality
Office of Land & Water Resources

IF MORE SPACE IS NEEDED, USE BACK

If well telescopes please sketch and show depths.

GROUND LEVEL

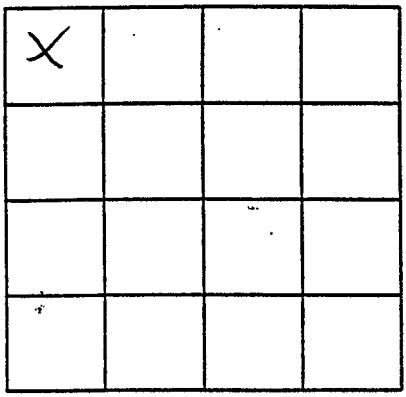

SECTION 28

Please indicate well location X.

ADDITIONAL INFORMATION

If more than one screen, show location of each on sketch.