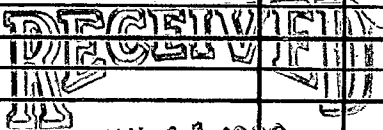


LINCOLN
G-201
6-5-86

MISSISSIPPI DEPARTMENT OF NATURAL RESOURCES
Bureau of Land and Water Resources
Southport Mall
P.O. Box 10631
Jackson, Mississippi 39209
WATER WELL DRILLERS LOG


CODED

6/5 1986 Jerry Guinn Water Well Serv Lincoln
date well completed firm name county well located

LANDOWNER:	description of formations encountered	from	to
Dennis Smith 809 Wall St Brookhaven, Ms 39601 (mailing address)			
WELL LOCATION:			
sec. <u>15</u> T. <u>7</u> N. R. <u>7</u> E	CODED		
<u>1</u> miles <u>W</u> of <u>Brookhaven</u> (distance) (direction) (nearest town)			
WELL PURPOSE: <u>Industrial</u> (home, irrigation, municipal, industrial)			
WELL COMPLETION DATA:			
(1) diameter (inches) <u>4</u>			
(2) total depth (feet) <u>165</u>			
(3) static water level (feet) <u>50</u> below top of ground.			
(4) casing <u>PVC</u> , <u>110'</u> (material) (depth) <u>4"</u> if telescope see back. (size)			
(5) screen <u>50'</u> , <u>110'</u> (length) (depth to top) <u>4"</u> , <u>PVC</u> (size) (material)			
(6) pump <u>3</u> <u>40</u> (HP) (yield gpm) <u>electricity</u> (type power)			
(7) electric log <u>Yes</u> (yes or no) <u>Ms Geological Survey</u> (organization running log)	 JUL 13 1986 Department of Natural Resources Bureau of Land & Water Resources		
(8) how well bottom plugged <u>Backwash</u> <u>Value</u>			
DRILLERS REMARKS:			

If well telescopes please sketch and show depths.

GROUND LEVEL

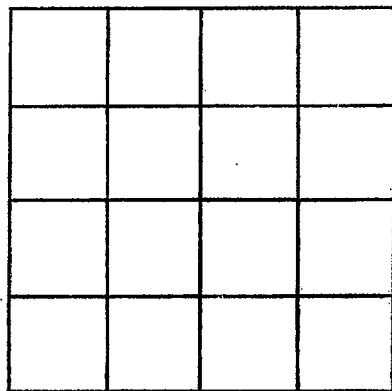

SECTION _____

Please indicate well location X.

ADDITIONAL INFORMATION

If more than one screen,
show locations of each on sketch.