MISSISSIPPI DEPARTMENT OF NATURAL RESOURCES

Bureau of Land and Water Resources

P.O. Box 10631
Jackson, Mississippi 39209
WATER WELL DRILLERS LOG

COUNTY WELL LOCATED: Lincoln	
WELL NUMBER: G 254	CODED:
PERMIT NUMBER:	
NAME OF DRILLING FIRM: Grenn Water Well & Supply Inc.	
DATE WELL COMPLETED: 1-3-89	

NAME & MAILING ADDRESS OF LANDOWNER
Ricky Case
P.O. Box 32
Brookhaven, Miss.

WELL LOCATION: SEC 36 TOWNSHIP 7 (N) S RANGE 7 (E) W

DISTANCE 2 Miles DIRECTION SE of NEAREST TOWN Brookhaven

OTHER LANDMARK

WELL PURPOSE: Home, Irrigation, Municipal, Industrial, Fish Pond, etc.

PUMP DATA

PUMP TYPE (Circle One): Submersible, Turbine, Jet Flowing Well, Other (Describe)

POWER TYPE (Circle One): Electric, Tractor, Diesel, Gasoline, Butane, Other (Describe) H/P 1/2

Pump Capacity (GPM)	No. of Stages	Setting Depth
10	10	70 FT.

PUMP TEST

Well yielded 14 GPM with a drawdown of 0 ft. after 2 hours of pumping

WELL DATA

Well Depth	Casing Diameter (In.)	Casing Length (Ft.)
155	4	145

Type of Casing	Hole Depth	Depth to Static Water Level
PVC	165	45

TYPE OF COMPLETION: (Circle One or More): Gravel Packed, Underreamed, Telescoped, Natural Development, Open Hole, Other (Describe)

Top of Lap Pipe or Reduction in Casing FEET

IF TELESCOPED OR MORE THAN ONE SCREEN: USE BACK PAGE

LOG DATA

TYPE OF LOG RUN (Circle One): No Log Run, Electric, Gamma Ray, Density, Sonic, Neutron, Other (Describe)

Name of Organization Running Log

GEOLOGIC DATA (Office Use Only)

Surface Elev.	Geologic Unit	Unit Thickness	Depth to Top
Subs. SWL	Date	Analysis	Aquifer Test

Driller's Remarks

SCREEN DATA

Diameter - Inches	Length - Feet	Slot Size - Inches
4	10	.010

Screen Type	Depth to Bottom - Feet
PVC	155

DESCRIPTION OF FORMATIONS ENCOUNTERED	FROM	TO
Citronelle	0	30
Clay	30	100
Sand	100	155
Clay	155	165

FORMATIONS (Continued) | FROM | TO

RECEIVED
FEB 27 1989
Department of Natural Resources
Bureau of Land & Water Resources

IF MORE SPACE IS NEEDED, USE BACK

If well telescopes please
sketch and show depths.

GROUND LEVEL

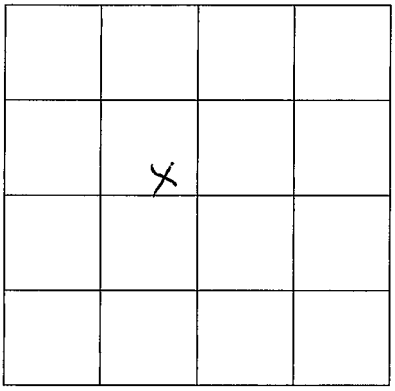

SECTION 36

Please indicate well location X.

ADDITIONAL INFORMATION

If more than one screen,
show location of each on sketch.