Lincoln
G 335
7-21-81

MISSISSIPPI
BOARD OF WATER COMMISSIONERS
416 North State Street
Jackson, Mississippi 39201

WATER WELL DRILLERS LOG

Jul 21, 19 81 — Grenn Water Well Cont. — Lincoln
date well completed — firm name — county well located

LANDOWNER: W. G. Sellers
Route 5, Box 280 E
Brookhaven, Ms.
(mailing address)

WELL LOCATION:
NE NW sec. 25 T 7 (N/S) R 7 (E/W)
1 (distance) miles S (direction) of Brookhaven (nearest town)

WELL PURPOSE: home
(home, irrigation, municipal, industrial)

WELL COMPLETION DATA:

(1) diameter (inches) 4
(2) total depth (feet) 180
(3) static water level (feet) 50 below above top of ground.
(4) casing PVC (material), 170 (depth), 4" (size) if telescope see back.
(5) screen 10' (length), 170' (depth to top), .010 (size), PVC (material)
(6) pump 1/2 sub (HP) 8 (yield gpm)
electricity (type power)
(7) electric log no (yes or no)
(organization running log)
(8) how well bottom plugged back wash valve

DRILLERS REMARKS:

description of formations encountered	from	to
clay	1	20
sand & gravel	20	50
white clay	50	120
sand	120	180

DEPT. OF NATURAL RESOURCES
BUREAU OF LAND & WATER RESOURCES
AUG 14 1981
RECEIVED

If well telescopes please sketch and show depths.

GROUND LEVEL

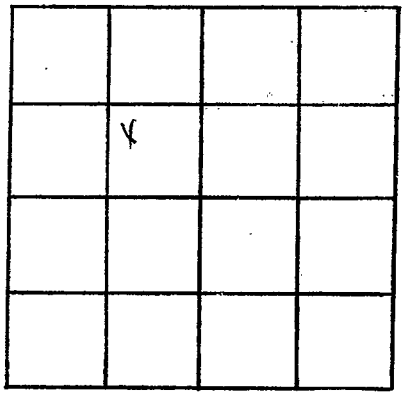

SECTION 25

Please indicate well location X.

ADDITIONAL INFORMATION

If more than one screen, show locations of each on sketch.