County: Lincoln

Permit #:

Driller: Fitzgerald Well Service

Date drilling completed: 7-8-05

State Well Report

Part 1 – Driller's Log

Mississippi Department of Environmental Quality
Office of Land and Water Resources
P.O. Box 10631
Jackson, MS 39289-0631
(601)961-5210
(601)354-6938 (fax)

For Office Use Only:

Aquifer:

Well #: G-469

L. S. Elevation:

E-log #:

State Law requires that this report be prepared by the license holder responsible for the work and filed with the Department at the above address within 30 days of completion of drilling of the well or borehole.

Information on Well Owner
(Landowner if borehole is not for a water well)

Owner Name: Gill Vandan

Mailing Address: Mills Rd

Brookhaven MS
City State Zip Code

Telephone No. ( )

Well or Borehole Location

Latitude: 31 ° 32 ' 08 " Longitude: 90 ° 31 ' 47 "

Method of Lat Long (circle one): Conventional Survey,

USGS quad, Hand-held GPS, Survey-grade GPS

NW ¼ NW ¼ Sec. 32 Twn. 7N Rng. 7E

Distance 5 Miles Direction West of Nearest Town Brookhaven

Well / Borehole Data

Date drilling started: 7-8-05 Date drilling completed: 7-8-05 Hole depth: 85' Hole diameter: 8"

Location of the source of any surface water used for drilling:

Method of dosing and volume of Chlorine used in drilling and development:

Logs run (circle all applicable): (No log run) Electric Gamma Ray Density Sonic Neutron Other:

Name of organization running log(s):

Purpose of borehole (check one): Water Well ✓ Geotechnical Geological Investigation ___ Ground Source Heat Pump ___

Seismic Survey ___ Other (*describe*)

If drilling is not related to water well construction, skip the remainder of this block

Purpose of Well (check one): Home ✓ Industrial ___ Public Supply ___ Irrigation ___ Fish Culture ___ Other:

If a flowing well, method of flow regulation: Valve ___ Other (describe)

Static Water Level: 57' feet above or below (circle one) land surface Date measured: 7-8-05

Method of Measurement (circle one) (steel tape) electric tape air line other:

Well depth: 85' Well grouted to a depth of 10' feet Type of grout (circle one): (Neat Cement) Bentonite Mix

Casing length: 75' feet Casing diameter: 4" inches Type of casing: PVC

Screen length: 10' feet Screen diameter: 4" inches Type of screen: PVC

Screen slot size: .012 inches Setting depth: From 75' feet to 85' feet

Type of completion (circle all applicable): (Gravel packed) Underreamed Telescoped Open hole Natural Development

Other (describe):

Top of lap pipe or reduction in casing: feet. ***If telescoped or more than one screen, describe on next page***

Form: OLWR SWR 4

RECEIVED
JUL 21 2005
BY: OLWR

G-469

The sketch below only required for water wells

If well telescopes, show depths on sketch.

Ground Level

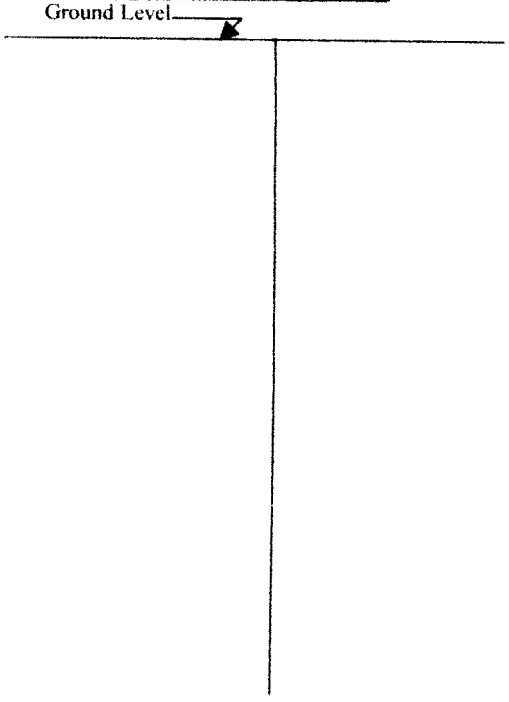

If more than one screen, show location of each on sketch

Description of formations encountered must be provided for all wells and boreholes, unless specifically exempted by regulations

Description of Formations Encountered	From (depth) Ground Level	To (depth)
clay	0	20
gravel	20	40
clay	40	60
sand	60	70
coarse sand & gravel	70	85

Sketch the property layout and include the following: 1) the well location; 2) any permanent structures on the property that may aid in locating the well; 3) any roads, power lines, or other items that may aid in locating the property and the well; 4) a north arrow.

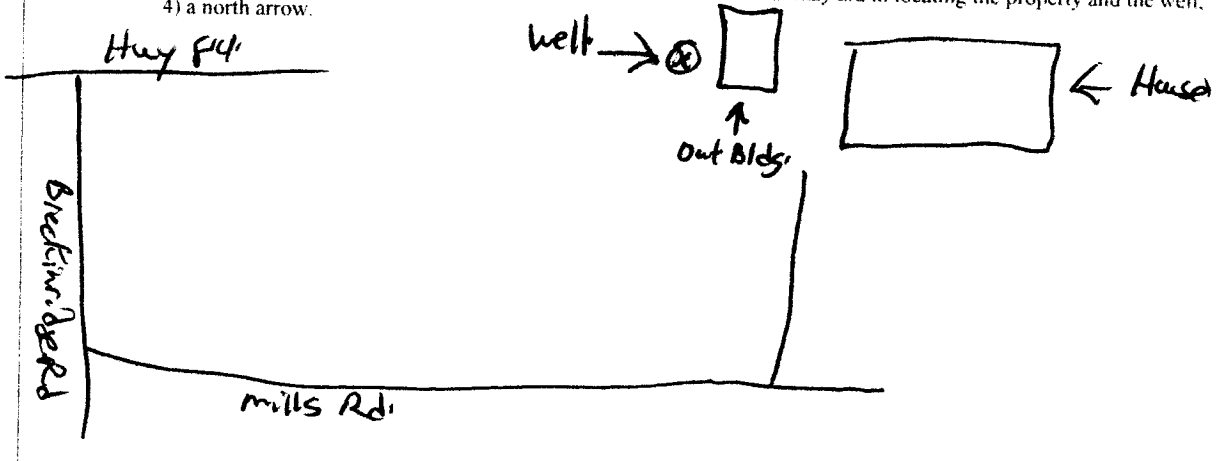

Landowner Name: Gill Vardaw

Form: OLWR-SWR-1A

I certify that the well/borehole was drilled, constructed, and completed in accordance with all applicable requirements of the Mississippi Department of Environmental Quality and the Mississippi Department of Health regulations, if applicable, and state laws.

Brad Fitzgerald 029. 7-8-05 Brad Stynsky

Print Name of Responsible Licensee and License No. **Date** **Signature of Licensee**

RECEIVED
JUL 21 2005
BY: OLWR

STATE WELL REPORT

Part 2

Pump Installer's Completion Report
Mississippi Department of Environmental Quality
Office of Land and Water Resources
P.O. Box 10631
Jackson, MS 39289-0631
(601)961-5210
(601)354-6938 (fax)

County: Lincoln
Permit #:
Driller: Fitzgerald Well Service
Date completed: 7-8-05
Copy information from block on Part 1

For Office Use Only:
Aquifer:
Well #: G-469
Elevation:

This part of the report must be completed by a licensed water well contractor or a licensed pump installer. A copy of Part 1 of the report must be attached and both parts filed with the Department at the above address within 30 days of well completion.

Well Owner Information

Owner Name: Gill Vandan
Mailing Address: mills Rd
Brookhaven MS
City State Zip Code
Telephone No. ( )

Well Location

Latitude: Longitude:
Method of Lat/Long (check one): Conventional Survey, USGS quad, Hand-held GPS, Survey-grade GPS
¼ ¼ Sec 32 T 7N R 7E
Distance Direction Nearest Town
5 Miles West of Brookhaven

Pump Type
Circle one

Air Lift | Jet | (Submersible)
Bucket | Piston | Turbine
Centrifugal | Rotary | Flowing Well
Other (specify):
Date Pump Installed: 7-8-05
Rated Pump Capacity: 12 Gallons Per Minute

Power Type
Circle one

Diesel Engine | Gasoline Engine | Natural Gas
(Electric Motor) | Hand | Tractor PTO
Windmill | Other (specify):
Horse Power Rating of Motor: 3/4
Setting Depth: 80 feet
Number of Stages: 12

Pump Test Data

Date Well Tested:
Static Water Level (A): Feet Below Land Surface
Pumping Water Level (B): Feet Below Land Surface
Drawdown [(B) – (A)]: Feet Below Land Surface
Test Pumping Rate: Gallons Per Minute
Duration of Pump Test (minimum 4 hours): hours

Method of Measuring Water Level
Circle one

Air Line | Electric Measuring Line | (Steel Tape)
Other (specify):
For flowing well, measured shut in head: feet
Well yielded GPM with a drawdown of
feet after hours of pumping

I HEREBY CERTIFY that the above statements are true to the best of my knowledge.

Brad Fitzgerald aqa.
Print Name of Pump Installer and License No. (if applicable)

Brad Stynd
Signature of Pump Installer

Form: OLWR-SWR-1B

RECEIVED
JUL 21 2005
BY: OLWR