

Lincoln
G
2005

MISSISSIPPI DEPARTMENT OF NATURAL RESOURCES
 Bureau of Land and Water Resources
 Southport Mall
 P.O. Box 10631
 Jackson, Mississippi 39209
WATER WELL DRILLERS LOG

6/20 1986 Jeery Guinn Water Well Serv Lincoln
 date well completed firm name county well located

LANDOWNER: Jim Tatham
P.O. Box 3515
Brockhaven Ms 39601
 (mailing address)

| description of formations encountered | from | to |
|---------------------------------------|-----------|-----------|
| <u>Clay</u> | <u>0</u> | <u>40</u> |
| <u>Sand & Gravel</u> | <u>40</u> | <u>70</u> |


WELL LOCATION:
 sec. 5 T. 7 N. R. 7 E
4 1/2 miles SW of B'Haven
 (distance) (direction) (nearest town)

WELL PURPOSE: Home
 (home, irrigation, municipal, industrial)

- WELL COMPLETION DATA:
- (1) diameter (inches) 4
 - (2) total depth (feet) 70
 - (3) static water level (feet) 38 below above top of ground.
 - (4) casing PVC 40'
 (material) (depth)
4" if telescope see back.
 (size)
 - (5) screen 30' 40'
 (length) (depth to top)
4" PVC
 (size) (material)
 - (6) pump 1/2 10
 (HP) (yield gpm)
electricity
 (type power)
 - (7) electric log No
 (yes or no)

 (organization running log)
 - (8) how well bottom plugged Backwash
Value


DRILLERS REMARKS: _____

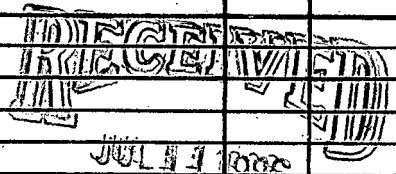

Department of Natural Resources
 Bureau of Land & Water Resources

If well telescopes please sketch and show depths.

GROUND LEVEL

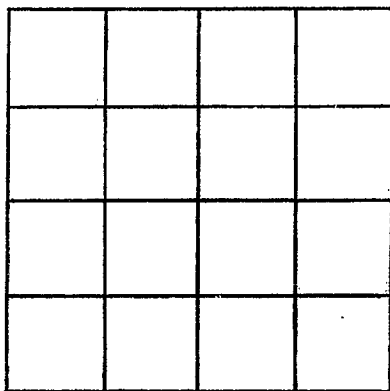

SECTION _____

Please indicate well location X.

ADDITIONAL INFORMATION

If more than one screen,
show locations of each on sketch.