MISSISSIPPI DEPARTMENT OF ENVIRONMENTAL QUALITY
Bureau of Land and Water Resources

P. O. Box 10631
Jackson, MS 39289-0631
WATER WELL DRILLERS LOG

COUNTY WELL LOCATED: Lincoln	
WELL NUMBER: G-2021	CODED:
DATE WELL COMPLETED: 10-8-94	
PERMIT NUMBER:	
NAME OF DRILLING FIRM: Green Water Well & Supply	

NAME & MAILING ADDRESS OF LANDOWNER
Jason Oliver
396 Brockenridge Ln NW
Brookhaven MS 39601

WELL LOCATION: SEC 32 TOWNSHIP 7 (N) S RANGE 7 (E) W

DISTANCE 4 Miles DIRECTION S.W. NEAREST TOWN of Brookhaven

OTHER LANDMARK

WELL PURPOSE: (Home), Irrigation, Municipal, Industrial, Fish Pond, etc.

PUMP DATA

PUMP TYPE (Circle One): (Submersible), Turbine, Jet, Flowing Well, Other (Describe)

POWER TYPE (Circle One): (Electric), Tractor, Diesel, Gasoline, Butane, Other (Describe) H/P 2

Pump Capacity (GPM)	No. of Stages	Setting Depth
10	9	72 FT.

PUMP TEST

Well yielded 10 GPM with a drawdown of 0 ft. after 2 hours of pumping

WELL DATA

Well Depth	Casing Diameter (In.)	Casing Length (Ft.)
76 ft.	4 in.	66 ft.
Type of Casing	**Hole Depth**	**Depth to Static Water Level**
PVC	80	45 ft.

TYPE OF COMPLETION: (Circle One or More): (Gravel Packed), Underreamed, Telescoped, Natural Development, Open Hole, Other (Describe)

Top of Lap Pipe or Reduction in Casing FEET

IF TELESCOPED OR MORE THAN ONE SCREEN: USE BACK PAGE

LOG DATA

TYPE OF LOG RUN (Circle One): (No Log Run), Electric, Gamma Ray, Density, Sonic, Neutron, Other (Describe)

Name of Organization Running Log

GEOLOGIC DATA (Office Use Only)

Surface Elev.	Geologic Unit	Unit Thickness	Depth to Top
Subs. SWL	Date	Analysis	Aquifer Test

Driller's Remarks

SCREEN DATA

Diameter - Inches	Length - Feet	Slot Size - Inches
4 in.	10 ft.	.010
Screen Type	**Depth to Bottom - Feet**	
PVC	76 ft.	

DESCRIPTION OF FORMATIONS ENCOUNTERED	FROM	TO
Red Clay	0	20
Sand	20	50
Sand & Gravel	50	80
White Clay	80	85

FORMATIONS (Continued) FROM TO

RECEIVED
FEB 13 1995
Dept. of Environmental Quality
Office of Land & Water Resources

IF MORE SPACE IS NEEDED, USE BACK

If well telescopes please
sketch and show depths.

GROUND LEVEL

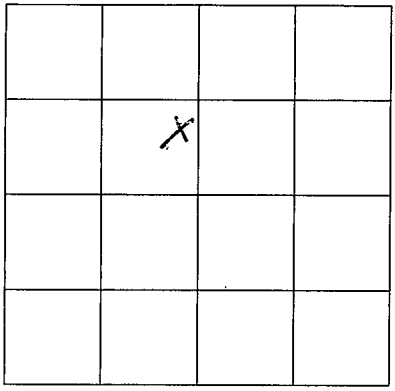

SECTION 32

Please indicate well location X.

ADDITIONAL INFORMATION

If more than one screen,
show location of each on sketch.