MISSISSIPPI DEPARTMENT OF ENVIRONMENTAL QUALITY
Office of Land and Water Resources

P. O. Box 10631
Jackson, MS 39289-0631
WATER WELL DRILLERS LOG

COUNTY WELL LOCATED: Lincoln	PERMIT NUMBER: 0-287
WELL NUMBER: G 2019 CODED	NAME OF DRILLING FIRM: Reeves well Ser.
DATE WELL COMPLETED: 11-26-97	

NAME & MAILING ADDRESS OF LANDOWNER: Ray Cowart

WELL LOCATION: SEC 15 TOWNSHIP 7 (N) S RANGE 7 (E) W

DISTANCE 3 Miles DIRECTION SW of NEAREST TOWN Bogue Chitto

OTHER LANDMARK:

WELL PURPOSE: Home, Irrigation, Municipal, Industrial, Fish Pond, etc.: HOME

PUMP DATA

PUMP TYPE (Circle One): (Submersible) Turbine, Jet Flowing Well, Other (Describe)

POWER TYPE (Circle One): (Electric) Tractor, Diesel, Gasoline, / Butane, Other (Describe) H/P

Pump Capacity (GPM)	No. of Stages	Setting Depth
19	14	65 FT.

PUMP TEST
Well yielded 40 GPM with
a drawdown of 0 ft.
after 1 hours of pumping

WELL DATA

Well Depth	Casing Diameter (In.)	Casing Length (Ft.)
70'	4"	20'

Type of Casing	Hole Depth	Depth to Static Water Level
PVC	70'	40'

TYPE OF COMPLETION: (Circle One or More): Gravel Packed, Underreamed, Telescoped, Natural Development, Open Hole, Other (Describe) 10 gal Sand

WELL GROUTED TO A DEPTH OF 10 FEET
Type Grout (circle one): (Cement), Bentonite, or Mix

LOG DATA

TYPE OF LOG RUN (Circle One): No Log Run, Electric, Gamma Ray, Density, Sonic, Neutron, Other (Describe)

Name of Organization Running Log

GEOLOGIC DATA (Office Use Only)

Surface Elev.	Geologic Unit	Unit Thickness	Depth to Top
Subs. SWL	Date	Analysis	Aquifer Test

Driller's Remarks

SCREEN DATA

Diameter - Inches	Length - Feet	Slot Size - Inches
4"	10'	10 Thds.

Screen Type	Depth to Bottom - Feet
PVC	70'

Top of Lap Pipe or Reduction in Casing
FEET — IF TELESCOPED OR MORE THAN ONE SCREEN: USE BACK PAGE

DESCRIPTION OF FORMATIONS ENCOUNTERED	FROM	TO	FORMATIONS (Continued)	FROM	TO
clay	0	10			
sand & gravel	10	70			
			06-23-98A09:36 RCVD		
			06-23-98 A09:35 OUT		
			IF MORE SPACE IS NEEDED, USE BACK		

If well telescopes please
sketch and show depths.

GROUND LEVEL

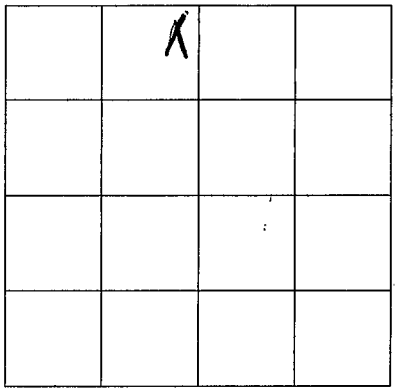

SECTION 15

Please indicate well location X.

ADDITIONAL INFORMATION

If more than one screen,
show location of each on sketch.