MISSISSIPPI DEPARTMENT OF ENVIRONMENTAL QUALITY
Office of Land and Water Resources

P. O. Box 10631
Jackson, MS 39289-0631
WATER WELL DRILLERS LOG

COUNTY WELL LOCATED: Lincoln	
WELL NUMBER: G-2142	CODED:
DATE WELL COMPLETED: 8/11/00	
PERMIT NUMBER:	
NAME OF DRILLING FIRM: Green Water Well & Supply	

NAME & MAILING ADDRESS OF LANDOWNER
Roland Cupit (Scot Nations)
761 Rollins Dr NW
Brookhaven MS 39601

WELL LOCATION	SEC	TOWNSHIP	RANGE
	28	7 N/S	7 E/W

DISTANCE	DIRECTION	NEAREST TOWN
2 Miles	SW	of Brookhaven

OTHER LANDMARK:

WELL PURPOSE: (Home) Irrigation, Municipal, Industrial, Fish Pond, etc.

PUMP DATA

PUMP TYPE (Circle One): Submersible, Turbine, Jet, Flowing Well, Other (Describe) ____

POWER TYPE (Circle One): Electric, Tractor, Diesel, Gasoline, Butane, Other (Describe) ____ H/P ____

Pump Capacity (GPM)	No of Stages	Setting Depth
		FT.

PUMP TEST
Well yielded ____ GPM with a drawdown of ____ ft. after ____ hours of pumping

WELL DATA

Well Depth	Casing Diameter (In.)	Casing Length (Ft.)
40	4	20

Type of Casing	Hole Depth	Depth to Static Water Level
PVC	45	12

TYPE OF COMPLETION: (Circle One or More): (Gravel Packed) Underreamed, Telescoped, Natural Development, Open Hole, Other (Describe) ____

WELL GROUTED TO A DEPTH OF 10 FEET
Type Grout (circle one): Cement, Bentonite, or (Mix)

LOG DATA

TYPE OF LOG RUN (Circle One): (No Log Run) Electric, Gamma Ray, Density, Sonic, Neutron, Other (Describe) ____

Name of Organization Running Log:

SCREEN DATA

Diameter - Inches	Length - Feet	Slot Size - Inches
4	20	.010

Screen Type	Depth to Bottom - Feet
PVC	40

GEOLOGIC DATA (Office Use Only)

Surface Elev	Geologic Unit	Unit Thickness	Depth to Top
Subs SWL	Date	Analysis	Aquifer Test

Driller's Remarks:

Top of Lap Pipe or Reduction in Casing: FEET

IF TELESCOPED OR MORE THAN ONE SCREEN: USE BACK PAGE

DESCRIPTION OF FORMATIONS ENCOUNTERED	FROM	TO
Red Clay	0	11
Sand & Gravel	11	36
White Clay	36	45

FORMATIONS (Continued)	FROM	TO

IF MORE SPACE IS NEEDED, USE BACK

RECEIVED
MAR 19 2001
Dept. of Environmental Quality
Office of Land & Water Resources

If well telescopes please sketch and show depths.

GROUND LEVEL

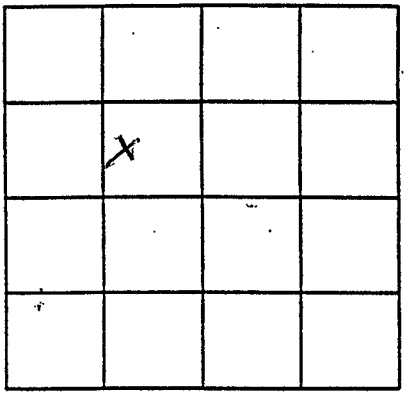

SECTION 28

Please indicate well location X.

ADDITIONAL INFORMATION

If more than one screen, show location of each on sketch.