MISSISSIPPI DEPARTMENT OF ENVIRONMENTAL QUALITY
Office of Land and Water Resources

P. O. Box 10631
Jackson, MS 39289-0631

WATER WELL DRILLERS LOG

COUNTY WELL LOCATED: Lincoln	
WELL NUMBER: G-2143	CODED:
DATE WELL COMPLETED: 8-19-00	
PERMIT NUMBER:	
NAME OF DRILLING FIRM: Green Water Well & Supply	

NAME & MAILING ADDRESS OF LANDOWNER
Janine Adams
968 Zetus Rd NW
Brookhaven MS 39601

WELL LOCATION — SEC: 21 TOWNSHIP: 7 (N / S) RANGE: 7 (E / W)

DISTANCE: 2 Miles DIRECTION: W NEAREST TOWN: Brookhaven

OTHER LANDMARK:

WELL PURPOSE (Home, Irrigation, Municipal, Industrial, Fish Pond, etc.):

PUMP DATA

PUMP TYPE (Circle One): (Submersible) Turbine, Jet, Flowing Well, Other (Describe)

POWER TYPE (Circle One): (Electric) Tractor, Diesel, Gasoline, Butane, Other (Describe) H/P 1/2

Pump Capacity (GPM)	No of Stages	Setting Depth
10	9	80 FT.

PUMP TEST
Well yielded 10 GPM with a drawdown of 0 ft. after 1 hours of pumping

WELL DATA

Well Depth	Casing Diameter (In.)	Casing Length (Ft.)
160	4 in	150
Type of Casing	**Hole Depth**	**Depth to Static Water Level**
PVC	170	53

TYPE OF COMPLETION: (Circle One or More): (Gravel Packed) Underreamed, Telescoped, Natural Development, Open Hole, Other (Describe)

WELL GROUTED TO A DEPTH OF 10 FEET
Type Grout (circle one): Cement, Bentonite, or (Mix)

LOG DATA

TYPE OF LOG RUN (Circle One): (No Log Run) Electric, Gamma Ray, Density, Sonic, Neutron, Other (Describe)

Name of Organization Running Log

SCREEN DATA

Diameter - Inches	Length - Feet	Slot Size - Inches
4	10	.010
Screen Type		**Depth to Bottom - Feet**
PVC		160

GEOLOGIC DATA (Office Use Only)

Surface Elev	Geologic Unit	Unit Thickness	Depth to Top
Subs SWL	Date	Analysis	Aquifer Test

Driller's Remarks

Top of Lap Pipe or Reduction in Casing
FEET — IF TELESCOPED OR MORE THAN ONE SCREEN: USE BACK PAGE

DESCRIPTION OF FORMATIONS ENCOUNTERED	FROM	TO
Red Clay	0	18
Streaky	18	40
Sand & Gravel	40	57
White Clay	57	75
Blue Clay	75	97
Sand	97	161
Yellow Clay	161	167

FORMATIONS (Continued)	FROM	TO

IF MORE SPACE IS NEEDED, USE BACK

RECEIVED
MAR 19 2001
Dept of Environmental Quality
Office of Land & Water Resources

If well telescopes please
sketch and show depths.

GROUND LEVEL

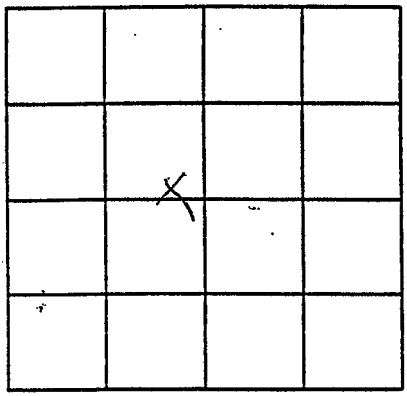

SECTION 21

Please indicate well location X.

ADDITIONAL INFORMATION

If more than one screen,
show location of each on sketch.