Lincoln
H58
7-23-74

MISSISSIPPI
BOARD OF WATER COMMISSIONERS
416 North State Street
Jackson, Mississippi 39201

CODED

WATER WELL DRILLERS LOG

July 23, 19 74 — date well completed
Grenn Water Well — firm name
Lincoln — county well located

LANDOWNER: James Williams
Southwest Paving

Brookhaven, Miss.
(mailing address)

WELL LOCATION:
sec. 4 T 7 N (S) R 8 E (W)
1/4 miles NE of Brookhaven
(distance) (direction) (nearest town)

WELL PURPOSE: industrial
(home, irrigation, municipal, industrial)

WELL COMPLETION DATA:
(1) diameter (inches) 6"
(2) total depth (feet) 161
(3) static water level (feet) 40 below ~~above~~ top of ground.
(4) casing PVC (material), 149 (depth), 4" (size) if telescope see back.
(5) screen 12 (length), 149 (depth to top) .010 (size), PVC (material)
(6) pump 7½ Sub. (HP) 80 (yield gpm) electric (type power)
(7) electric log no (yes or no)
(organization running log)
(8) how well bottom plugged wood

DRILLERS REMARKS:

description of formations encountered	from	to
citronelle	0	161

RECEIVED
OCT 25 1974
MISS. BD. OF WATER COMM.

If well telescopes please sketch and show depths.

GROUND LEVEL

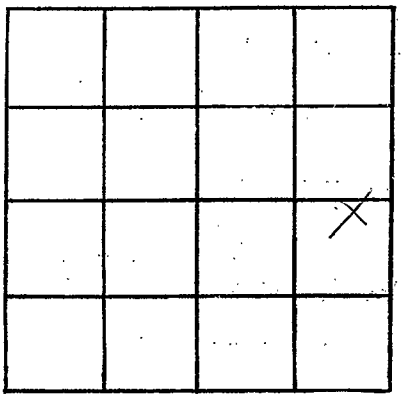

SECTION 4

Please indicate well location X.

ADDITIONAL INFORMATION

If more than one screen, show locations of each on sketch.