LINCOLN
H65

MISSISSIPPI DEPARTMENT OF NATURAL RESOURCES

Bureau of Land and Water Resources
Southport Mall
P.O. Box 10631
Jackson, Mississippi 39209

CODED

WATER WELL DRILLERS LOG

11-20 19 84 — date well completed
Grenn Water Well — firm name
Lincoln — county well located

LANDOWNER: Warren Holmes
Rt. 4. Box 310
Brookhaven, Ms.
(mailing address)

WELL LOCATION:
sec. 33 T 7 N/S R 8 E/W
3 (distance) miles SE (direction) of Brookhaven (nearest town)

WELL PURPOSE: home
(home, irrigation, municipal, industrial)

WELL COMPLETION DATA:

(1) diameter (inches) 4
(2) total depth (feet) 49
(3) static water level (feet) 21 below/above top of ground.
(4) casing PVC (material), 39' (depth), 4" (size) if telescope see back.
(5) screen 10' (length), 39' (depth to top), .010 (size), PVC (material)
(6) pump 1/2 sub (HP) 10 (yield gpm)
electricity (type power)
(7) electric log no (yes or no)
(organization running log)
(8) how well bottom plugged
back wash valve

DRILLERS REMARKS:

description of formations encountered	from	to
Citronelle	1	49

CODED

RECEIVED
APR 16 1985
Department of Natural Resources
Bureau of Land & Water Resources

If well telescopes please sketch and show depths.

GROUND LEVEL

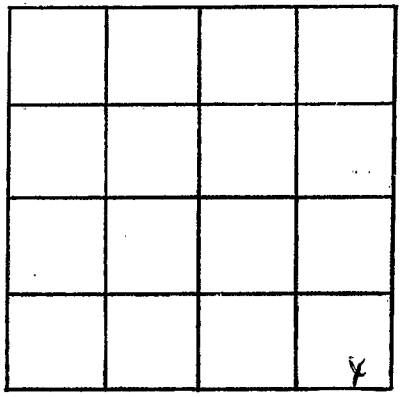

SECTION 33

Please indicate well location X.

ADDITIONAL INFORMATION

If more than one screen, show locations of each on sketch.