MISSISSIPPI DEPARTMENT OF ENVIRONMENTAL QUALITY
Office of Land and Water Resources

P. O. Box 10631
Jackson, MS 39289-0631

WATER WELL DRILLERS LOG

COUNTY WELL LOCATED	LINCOLN
WELL NUMBER	#3
CODED	
	H-81
DATE WELL COMPLETED	5-19-00
PERMIT NUMBER	MS-GW-15575
NAME OF DRILLING FIRM	GRINER DRILLING SERVICE

NAME & MAILING ADDRESS OF LANDOWNER

DICKERSON & BOWEN

P. O. BOX 1008

BROOKHAVEN, MS 39601

WELL LOCATION	SEC	TOWNSHIP	RANGE
	01	07 (N) S	08 (E) W

DISTANCE	DIRECTION	NEAREST TOWN
4 Miles	NE	of BROOKHAVEN

OTHER LANDMARK: 6 MILES NORTH OF BUS. 84

WELL PURPOSE Home, Irrigation, Municipal, Industrial, Fish Pond, etc.: INDUSTRIAL

PUMP DATA

PUMP TYPE (Circle One): (Submersible,) Turbine, Jet, Flowing Well, Other (Describe) _____

POWER TYPE (Circle One): (Electric,) Tractor, Diesel, Gasoline, Butane, Other (Describe) _____ H/P 40

Pump Capacity (GPM)	No of Stages	Setting Depth
350	4	192 FT.

PUMP TEST: NO TEST RUN

Well yielded _____ GPM with a drawdown of _____ ft. after _____ hours of pumping

WELL DATA

Well Depth	Casing Diameter (In.)	Casing Length (Ft.)
220'	12	90

Type of Casing	Hole Depth	Depth to Static Water Level
STEEL	265'	26'

TYPE OF COMPLETION: (Circle One or More): (Gravel Packed,) Underreamed, Telescoped, Natural Development, Open Hole, Other (Describe) _____

WELL GROUTED TO A DEPTH OF 70 FEET
Type Grout (circle one): Cement, Bentonite, or (Mix)

LOG DATA

TYPE OF LOG RUN (Circle One): (Electric, Gamma Ray,) Density, Sonic, Neutron, No Log Run, Other (Describe) _____

Name of Organization Running Log: GRINER DRILLING SERVICE, INC.

GEOLOGIC DATA (Office Use Only)

Surface Elev	Geologic Unit	Unit Thickness	Depth to Top
Subs. SWL	Date	Analysis	Aquifer Test

Driller's Remarks: WELL DRAWING ON BACK

Top of Lap Pipe or Reduction in Casing: FEET

IF TELESCOPED OR MORE THAN ONE SCREEN: USE BACK PAGE

SCREEN DATA

Diameter - Inches	Length - Feet	Slot Size - Inches
8	50	0.020

Screen Type	Depth to Bottom - Feet
ROD BASE	120' - 220'

DESCRIPTION OF FORMATIONS ENCOUNTERED	FROM	TO
SAND AND GRAVEL	0	130
CLAY	130	195
SAND	195	225
CLAY	225	260

FORMATIONS (Continued)	FROM	TO

IF MORE SPACE IS NEEDED, USE BACK

RECEIVED
JUN 07 2000
Dept. of Environmental Quality
Office of Land & Water Resources

If well telescopes please sketch and show depths.

GROUND LEVEL

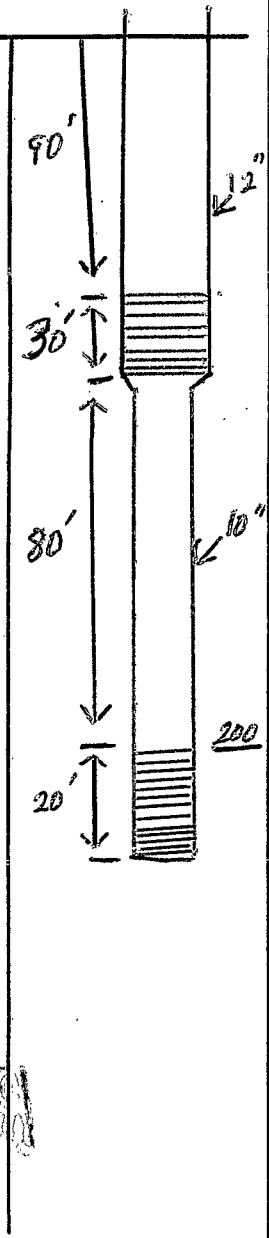

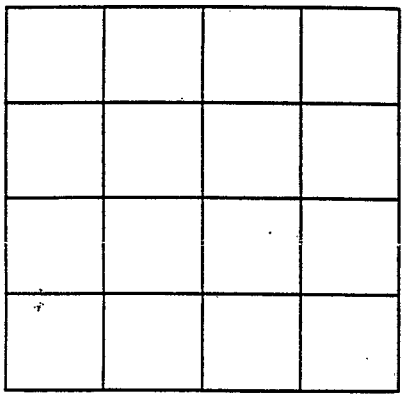

SECTION _____

Please indicate well location X.

ADDITIONAL INFORMATION

RECEIVED
JUN 0 7 '90
Dept. of Environmental Quality
Office of Water Resources

If more than one screen, show location of each on sketch.