LINCOLN
H 2012
9-1-77

MISSISSIPPI
BOARD OF WATER COMMISSIONERS
416 North State Street
Jackson, Mississippi 39201

130

WATER WELL DRILLERS LOG

Sept. 1 19 77 Grenn Water Well Cont. Lincoln
date well completed — firm name — county well located

LANDOWNER: Julius Burt
127 N. Cleveland
Brookhaven, Miss.
(mailing address)

WELL LOCATION:
sec. 30 T 7 (N) S R 8 (E) W
2 1½ miles (S) of Brookhaven
(distance) (direction) (nearest town)

WELL PURPOSE: home
(home, irrigation, municipal, industrial)

WELL COMPLETION DATA:

(1) diameter (inches) 6
(2) total depth (feet) 98
(3) static water level (feet) 35 below ~~above~~ top of ground.
(4) casing PVC (material), 86 (depth), 4010 (size) if telescope see back.
(5) screen 12' (length), 86' (depth to top), .010 (size), PVC (material)
(6) pump 1/2 sub (HP) 10 (yield gpm) electricity (type power)
(7) electric log no (yes or no)
(organization running log)
(8) how well bottom plugged back wash valve

DRILLERS REMARKS:

description of formations encountered	from	to
Citronelle	1	98

RECEIVED
OCT 26 1977
MISS. BD. OF WATER COMM.

If well telescopes please sketch and show depths.

GROUND LEVEL

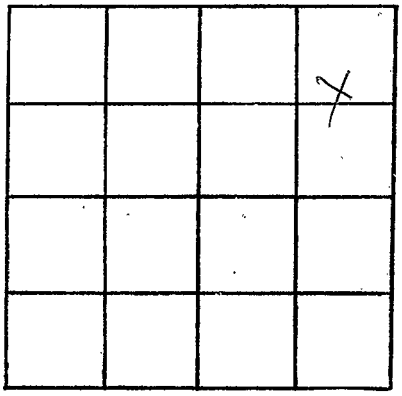

SECTION 30

Please indicate well location X.

ADDITIONAL INFORMATION

If more than one screen, show locations of each on sketch.