LINCOLN
H 2021
7-14-80

MISSISSIPPI
BOARD OF WATER COMMISSIONERS
416 North State Street
Jackson, Mississippi 39201

WATER WELL DRILLERS LOG

July 14 19 80 — date well completed
Grenn Water Well Cont. — firm name
Lincoln — county well located

LANDOWNER: Wallace Robinson
Route 2, Box 135
Bogue Chitto, Ms.
(mailing address)

WELL LOCATION:
sec. 32 T. 7 (N) S R 8 (E) W
3 (distance) miles SE (direction) of Brookhaven (nearest town)

WELL PURPOSE: home
(home, irrigation, municipal, industrial)

WELL COMPLETION DATA:

(1) diameter (inches) 4
(2) total depth (feet) 129
(3) static water level (feet) 48 below above top of ground.
(4) casing PVC (material), 119' (depth), 4" (size) if telescope see back.
(5) screen 10' (length), 119 (depth to top), .010 (size), PVC (material)
(6) pump 1/2 sub (HP) 8 (yield gpm)
electricity (type power)
(7) electric log no (yes or no)
(organization running log)
(8) how well bottom plugged backwash valve

DRILLERS REMARKS:

description of formations encountered	from	to
Citronelle	1	129

DEPT. OF NATURAL RESOURCES
BUREAU OF LAND & WATER RESOURCES
AUG 18 1980
RECEIVED

If well telescopes please sketch and show depths.

GROUND LEVEL

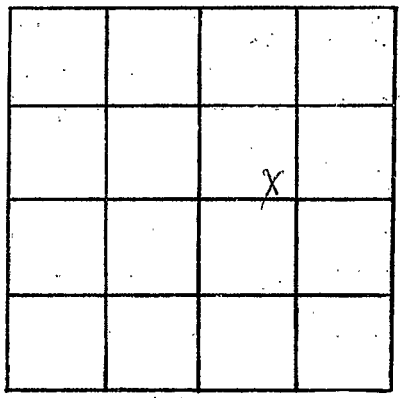

SECTION 32

Please indicate well location X.

ADDITIONAL INFORMATION

If more than one screen, show locations of each on sketch.