Lincoln
H 2023
8-19-80

MISSISSIPPI
BOARD OF WATER COMMISSIONERS
416 North State Street
Jackson, Mississippi 39201

WATER WELL DRILLERS LOG

Aug. 19 19 80 — date well completed
Grenn Water Well Cont. — firm name
Lincoln — county well located

LANDOWNER: Jeff Nettles
P.O. Box 877
Brookhaven, Ms.
(mailing address)

WELL LOCATION:
sec. 29 T 7 (N) S R 8 (E) W
1 (distance) miles S (direction) of Brookhaven (nearest town)

WELL PURPOSE: home
(home, irrigation, municipal, industrial)

WELL COMPLETION DATA:

(1) diameter (inches) 4
(2) total depth (feet) 98
(3) static water level (feet) 15 below above top of ground.
(4) casing PVC (material), 88 (depth),
4" (size) if telescope see back.
(5) screen 10' (length), 88' (depth to top)
.010 (size), PVC (material)
(6) pump 1/2 sub (HP) 10 (yield gpm)
electricity (type power)
(7) electric log no (yes or no)
(organization running log)
(8) how well bottom plugged
backwash valve

DRILLERS REMARKS:

description of formations encountered	from	to
Citronelle	1	98

If well telescopes please sketch and show depths.

GROUND LEVEL

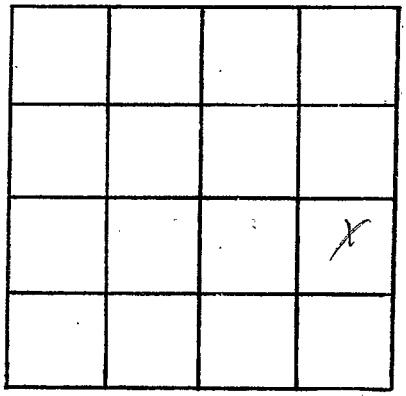

SECTION 29

Please indicate well location X.

ADDITIONAL INFORMATION

If more than one screen, show locations of each on sketch.