MISSISSIPPI DEPARTMENT OF NATURAL RESOURCES

Bureau of Land and Water Resources

P.O. Box 10631
Jackson, Mississippi 39209

WATER WELL DRILLERS LOG

COUNTY WELL LOCATED: Jefferson	
WELL NUMBER: H 2063	CODED:
DATE WELL COMPLETED: June 13-88	
PERMIT NUMBER:	
NAME OF DRILLING FIRM: FITZGERALD WELL SERV	

NAME & MAILING ADDRESS OF LANDOWNER

A. J. Hoff
RR - Brookhaven Miss.

WELL LOCATION: SEC	TOWNSHIP	RANGE
31	7 N S	8 E W

DISTANCE	DIRECTION	NEAREST TOWN
2 Miles	S	of Brookhaven

OTHER LANDMARK

WELL PURPOSE: Home, Irrigation, Municipal, Industrial, Fish Pond, etc.
Home

PUMP DATA

PUMP TYPE (Circle One): Submersible, Turbine, Jet, Flowing Well, Other (Describe)

POWER TYPE (Circle One): Electric, Tractor, Diesel, Gasoline, Butane, Other (Describe)

Pump Capacity (GPM)	No. of Stages	Setting Depth
10	10	120 FT.

PUMP TEST

Well yielded 10 GPM with a drawdown of 6 ft. after 2 hours of pumping

WELL DATA

Well Depth	Casing Diameter (In.)	Casing Length (Ft.)
185	4	175

Type of Casing	Hole Depth	Depth to Static Water Level
PVC	185	83

TYPE OF COMPLETION: (Circle One or More): Gravel Packed, Underreamed, Telescoped, Natural Development, Open Hole, Other (Describe)

Top of Lap Pipe or Reduction in Casing FEET

IF TELESCOPED OR MORE THAN ONE SCREEN: USE BACK PAGE

LOG DATA

TYPE OF LOG RUN (Circle One): No Log Run, Electric, Gamma Ray, Density, Sonic, Neutron, Other (Describe)

Name of Organization Running Log

GEOLOGIC DATA (Office Use Only)

Surface Elev.	Geologic Unit	Unit Thickness	Depth to Top
Subs. SWL	Date	Analysis	Aquifer Test

Driller's Remarks

SCREEN DATA

Diameter - Inches	Length - Feet	Slot Size - Inches
4	10	1014

Screen Type	Depth to Bottom - Feet
PVC	185

DESCRIPTION OF FORMATIONS ENCOUNTERED	FROM	TO
Red clay	0	20
Red Sand	20	80
White chalk	80	167
Course Sand & Gravel	167	185

FORMATIONS (continued) FROM TO

RECEIVED
AUG 03 1988
Department of Natural Resources
Bureau of Land & Water Resources

IF MORE SPACE IS NEEDED, USE BACK

If well telescopes please
sketch and show depths.

GROUND LEVEL

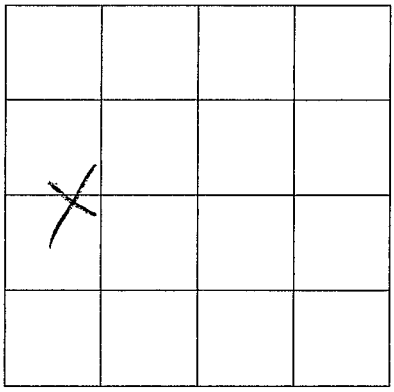

SECTION 31

Please indicate well location X.

ADDITIONAL INFORMATION

If more than one screen,
show location of each on sketch.