MISSISSIPPI DEPARTMENT OF ENVIRONMENTAL QUALITY
Office of Land and Water Resources

P. O. Box 10631
Jackson, MS 39289-0631

WATER WELL DRILLERS LOG

COUNTY WELL LOCATED: Lincoln	
WELL NUMBER: H 2109	CODED: 9
DATE WELL COMPLETED: 8-22-97	

FIRM NAME: Grenn Water Well & Supply
1318 Pricedale Dr. SE
NAME OF DRILLING FIRM: Bogue Chitto, MS 39629

NAME & MAILING ADDRESS OF LANDOWNER
Mike Warren
Rt. 1, Box 377
Brookhaven MS 39601

WELL LOCATION: SEC 8 TOWNSHIP 7 (N) S RANGE 8 (E) W

DISTANCE ½ Miles DIRECTION East of NEAREST TOWN Brookhaven

OTHER LANDMARK

WELL PURPOSE: (Home) Irrigation, Municipal, Industrial, Fish Pond, etc.

PUMP DATA

PUMP TYPE (Circle One): (Submersible) Turbine, Jet Flowing Well, Other (Describe)

POWER TYPE (Circle One): (Electric) Tractor, Diesel, Gasoline, Butane, Other (Describe) H/P ½

Pump Capacity (GPM)	No. of Stages	Setting Depth
10	9	70' FT.

PUMP TEST
Well yielded 10 GPM with a drawdown of 0 ft. after 1 hours of pumping

WELL DATA

Well Depth	Casing Diameter (In.)	Casing Length (Ft.)
130'	4	120'

Type of Casing	Hole Depth	Depth to Static Water Level
PVC	140	44

TYPE OF COMPLETION: (Circle One or More): (Gravel Packed) Underreamed, Telescoped, Natural Development, Open Hole, Other (Describe)

WELL GROUTED TO A DEPTH OF 10 FEET
Type Grout (circle one): Cement, Bentonite, or (Mix)

LOG DATA

TYPE OF LOG RUN (Circle One): (No Log Run) Electric, Gamma Ray, Density, Sonic, Neutron, Other (Describe)

Name of Organization Running Log

GEOLOGIC DATA (Office Use Only)

Surface Elev.	Geologic Unit	Unit Thickness	Depth to Top
Subs. SWL	Date	Analysis	Aquifer Test

Driller's Remarks

SCREEN DATA

Diameter - Inches	Length - Feet	Slot Size - Inches
4 in.	10 ft.	.010

Screen Type	Depth to Bottom - Feet
PVC	130'

Top of Lap Pipe or Reduction in Casing
FEET — IF TELESCOPED OR MORE THAN ONE SCREEN: USE BACK PAGE

DESCRIPTION OF FORMATIONS ENCOUNTERED	FROM	TO
Red Clay	0	13
Sand	13	60
Gravel	60	70
White Clay	70	79
Sand	79	140

FORMATIONS (Continued)	FROM	TO

RECEIVED
DEC 19 1997
Dept. of Environmental Quality
Office of Land & Water Resources

IF MORE SPACE IS NEEDED, USE BACK

If well telescopes please
sketch and show depths.

GROUND LEVEL

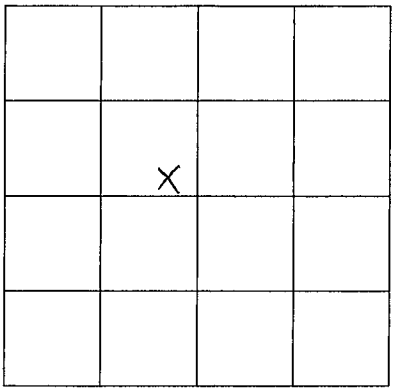

SECTION 8

Please indicate well location X.

ADDITIONAL INFORMATION

If more than one screen,
show location of each on sketch.