Lincoln
J 2004
9-15-77

MISSISSIPPI
BOARD OF WATER COMMISSIONERS
416 North State Street
Jackson, Mississippi 39201

WATER WELL DRILLERS LOG

Sept. 15 19 77 Glenn Water Well Con

date well completed firm name

Lincoln

county well located

LANDOWNER: John Carlisle

Route 1, Box 135 C

Brookhaven, Miss.

(mailing address)

WELL LOCATION:

sec 22 T 7 (N) S R 9 (E) W

9 (distance) miles E (direction) of Brookhaven (nearest town)

WELL PURPOSE: Home
(home, irrigation, municipal, industrial)

WELL COMPLETION DATA:

(1) diameter (inches) 6

(2) total depth (feet) 243

(3) static water level (feet) 95 below above top of ground.

(4) casing PVC (material), 231 (depth)
4" (size) if telescope see back.

(5) screen 12' (length), 231' (depth to top)
.010 (size), PVC (material)

(6) pump 3/4 (HP) sub 10 (yield gpm)
electricity (type power)

(7) electric log no (yes or no)
(organization running log)

(8) how well bottom plugged back wash valve

DRILLERS REMARKS:

description of formations encountered	from	to
white clay	1	40
blue clay	40	90
sand	90	95
blue clay	95	225
sand	225	243

RECEIVED
OCT 26 1977
MISS. BD. OF WATER COMM.

If well telescopes please sketch and show depths.

GROUND LEVEL

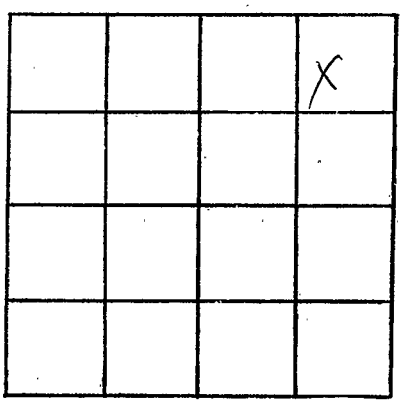

SECTION 22

Please indicate well location X.

ADDITIONAL INFORMATION

If more than one screen, show locations of each on sketch.