MISSISSIPPI DEPARTMENT OF NATURAL RESOURCES

Bureau of Land and Water Resources

P.O. Box 10631
Jackson, Mississippi 39209
WATER WELL DRILLERS LOG

COUNTY WELL LOCATED: LINCOLN	
WELL NUMBER: 168546- J 2036	CODED: #1
DATE WELL COMPLETED: 5-03-91	
PERMIT NUMBER: 510	
NAME OF DRILLING FIRM: EASLEY WATER WELL, BROOKHAVEN, MS 39601	

NAME & MAILING ADDRESS OF LANDOWNER: STEVE McBRIDE

WELL LOCATION: SEC 31 TOWNSHIP 7 (N) S RANGE 9 (E) W

DISTANCE 8 Miles DIRECTION E of NEAREST TOWN Brookhaven

OTHER LANDMARK:

WELL PURPOSE: Home, Irrigation, Municipal, Industrial, Fish Pond, etc.: HOME

PUMP DATA

PUMP TYPE (Circle One): Submersible, Turbine, Jet, Flowing Well, Other (Describe) NONE

POWER TYPE (Circle One): Electric, Tractor, Diesel, Gasoline, Butane, Other (Describe)

Pump Capacity (GPM)	No. of Stages	Setting Depth
		FT.

PUMP TEST

Well yielded PLUGGED GPM with a drawdown of _____ ft. after _____ hours of pumping

WELL DATA

Well Depth	Casing Diameter (In.)	Casing Length (Ft.)
294'	4"	274'

Type of Casing	Hole Depth	Depth to Static Water Level
PVC	294'	

TYPE OF COMPLETION: (Circle One or More): Gravel Packed, Underreamed, Telescoped, Natural Development, Open Hole, Other (Describe)

Top of Lap Pipe or Reduction in Casing: FEET

IF TELESCOPED OR MORE THAN ONE SCREEN: USE BACK PAGE

LOG DATA

TYPE OF LOG RUN (Circle One): No Log Run, Electric, Gamma Ray, Density, Sonic, Neutron, Other (Describe)

Name of Organization Running Log

GEOLOGIC DATA (Office Use Only)

Surface Elev.	Geologic Unit	Unit Thickness	Depth to Top
Subs. SWL	Date	Analysis	Aquifer Test

Driller's Remarks

SCREEN DATA

Diameter - Inches	Length - Feet	Slot Size - Inches
4"	20'	010

Screen Type	Depth to Bottom - Feet
PVC	294'

DESCRIPTION OF FORMATIONS ENCOUNTERED	FROM	TO
CLAY	0	20'
SAND & GRAVEL	20'	50'
CLAY	50'	140'
FINE SAND	140'	160'
SAND	160'	182'
CLAY	182'	270'
COARSE SAND	270'	294'

FORMATIONS (Continued) FROM TO

IF MORE SPACE IS NEEDED, USE BACK

RECEIVED
JUN 26 1992
Dept. of Environmental Quality
Bureau of Land & Water Resources

If well telescopes please
sketch and show depths.

GROUND LEVEL

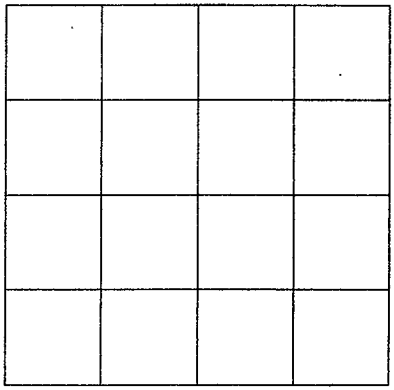

SECTION _____

Please indicate well location X.

ADDITIONAL INFORMATION

If more than one screen,
show location of each on sketch.