MISSISSIPPI DEPARTMENT OF ENVIRONMENTAL QUALITY
Bureau of Land and Water Resources

P. O. Box 10631
Jackson, MS 39289-0631
WATER WELL DRILLERS LOG

COUNTY WELL LOCATED: Lincoln	
WELL NUMBER: 20-41	CODED:
DATE WELL COMPLETED: 1-28-94	
PERMIT NUMBER:	
NAME OF DRILLING FIRM: Green Water Well & Supply	

NAME & MAILING ADDRESS OF LANDOWNER
Mike Lofton
Rt 1 Box 535
Brookhaven Ms.

WELL LOCATION: SEC 34 TOWNSHIP 7 (N) S RANGE 9 (E) W

DISTANCE 9 Miles DIRECTION East of NEAREST TOWN Brookhaven

OTHER LANDMARK

WELL PURPOSE: Home, Irrigation, Municipal, Industrial, Fish Pond, etc.
Chicken Houses

PUMP DATA

PUMP TYPE (Circle One):
Submersible, Turbine, Jet Flowing Well,
Other (Describe) _____

POWER TYPE (Circle One):
Electric, Tractor, Diesel, Gasoline, Butane,
Other (Describe) _____ H/P _____

Pump Capacity (GPM)	No. of Stages	Setting Depth
		FT.

PUMP TEST
Well yielded _____ GPM with
a drawdown of _____ ft.
after _____ hours of pumping

WELL DATA

Well Depth	Casing Diameter (In.)	Casing Length (Ft.)
87	4 in.	67
Type of Casing	**Hole Depth**	**Depth to Static Water Level**
PVC	90	33

TYPE OF COMPLETION: (Circle One or More):
Gravel Packed, Underreamed, Telescoped,
Natural Development, Open Hole, Other
(Describe) _____

Top of Lap Pipe or Reduction in Casing
FEET

IF TELESCOPED OR MORE THAN ONE SCREEN: USE BACK PAGE

LOG DATA

TYPE OF LOG RUN (Circle One): No Log Run.
Electric, Gamma Ray, Density, Sonic, Neutron,
Other (Describe) _____

Name of Organization Running Log

GEOLOGIC DATA (Office Use Only)

Surface Elev.	Geologic Unit	Unit Thickness	Depth to Top
Subs. SWL	Date	Analysis	Aquifer Test

Driller's Remarks

SCREEN DATA

Diameter - Inches	Length - Feet	Slot Size - Inches
4 in.	20 ft.	.010
Screen Type	**Depth to Bottom - Feet**	
PVC	87	

DESCRIPTION OF FORMATIONS ENCOUNTERED	FROM	TO
White Clay & Gravel Mix	0	19
Sand & Gravel	19	87
White Clay	87	90

FORMATIONS (Continued) FROM TO

RECEIVED
JUN 20 1994
Dept. of Environmental Quality
Office of Land & Water Resources

IF MORE SPACE IS NEEDED, USE BACK

If well telescopes please
sketch and show depths.

GROUND LEVEL

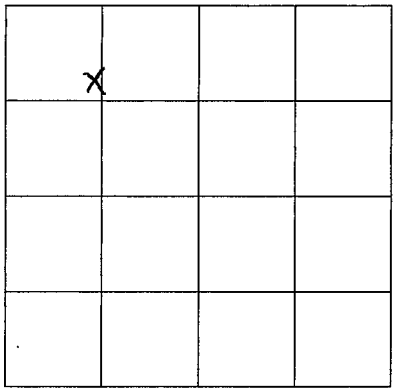

SECTION 34

Please indicate well location X.

ADDITIONAL INFORMATION

If more than one screen,
show location of each on sketch.