7/21/00

MISSISSIPPI DEPARTMENT OF ENVIRONMENTAL QUALITY
Office of Land and Water Resources

P. O. Box 10631
Jackson, MS 39289-0631

WATER WELL DRILLERS LOG

COUNTY WELL LOCATED: Lincoln

WELL NUMBER: D-2070 | CODED:

DATE WELL COMPLETED: 7-23-00

PERMIT NUMBER:

NAME OF DRILLING FIRM: Grenn Water Well & Supply

NAME & MAILING ADDRESS OF LANDOWNER:
Cricket Carlisle
362 Carlisle Ln
Brookhaven

WELL LOCATION: SEC 22 TOWNSHIP 7 (N) (S) RANGE 9 (E) (W)

DISTANCE: 8 Miles DIRECTION: E NEAREST TOWN: of Brookhaven

OTHER LANDMARK:

WELL PURPOSE: (Home) Irrigation, Municipal, Industrial, Fish Pond, etc.

PUMP DATA

PUMP TYPE (Circle One): (Submersible) Turbine, Jet Flowing Well, Other (Describe)

POWER TYPE (Circle One): (Electric) Tractor, Diesel, Gasoline, Butane, Other (Describe) H/P 1

Pump Capacity (GPM)	No of Stages	Setting Depth
10	15	140' FT.

PUMP TEST

Well yielded 10 GPM with a drawdown of 0 ft. after 1 hours of pumping

WELL DATA

Well Depth	Casing Diameter (In)	Casing Length (Ft)
220'	4'	200

Type of Casing	Hole Depth	Depth to Static Water Level
PVC	245'	108

TYPE OF COMPLETION: (Circle One or More): (Gravel Packed) Underreamed, Telescoped, Natural Development, Open Hole, Other (Describe)

WELL GROUTED TO A DEPTH OF 10 FEET
Type Grout (circle one): Cement, Bentonite, or (Mix)

LOG DATA

TYPE OF LOG RUN (Circle One): (No Log Run) Electric, Gamma Ray, Density, Sonic, Neutron, Other (Describe)

Name of Organization Running Log

GEOLOGIC DATA (Office Use Only)

Surface Elev	Geologic Unit	Unit Thickness	Depth to Top
Subs SWL	Date	Analysis	Aquifer Test

Driller's Remarks

SCREEN DATA

Diameter - Inches	Length - Feet	Slot Size - Inches
4	20	.010

Screen Type	Depth to Bottom - Feet
PVC	220'

Top of Lap Pipe or Reduction in Casing FEET

IF TELESCOPED OR MORE THAN ONE SCREEN, USE BACK PAGE

DESCRIPTION OF FORMATIONS ENCOUNTERED	FROM	TO
Mixed Clays	0	19
Sand	19	25
Gray Clay	25	65
Blue Clay	65	160
Blue Clay w/ Sand Streaks	160	208
Sand	208	218
Blue Clay	218	240

FORMATIONS (Continued)	FROM	TO

MAR 19 2001
Dept. of Environmental Quality
Office of Land & Water Resources

IF MORE SPACE IS NEEDED, USE BACK

If well telescopes please sketch and show depths.

GROUND LEVEL

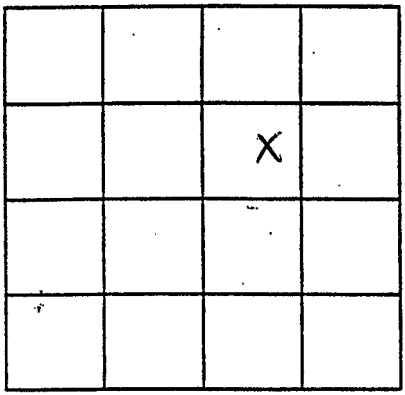

SECTION 22

Please indicate well location X.

ADDITIONAL INFORMATION

If more than one screen, show location of each on sketch.