Lincoln
K
4-17-81
2028

MISSISSIPPI
BOARD OF WATER COMMISSIONERS
416 North State Street
Jackson, Mississippi 39201

WATER WELL DRILLERS LOG

April 17 19 81 Grenn Water Well Cont. Lincoln
date well completed — firm name — county well located

LANDOWNER: Bradley Hall
Route 5, Box 74
Brookhaven, Ms.
(mailing address)

WELL LOCATION:
sec. 24 T 6 N/S R 6 E/W
4 (distance) miles NW (direction) of Brookhaven (nearest town)

WELL PURPOSE: home
(home, irrigation, municipal, industrial)

WELL COMPLETION DATA:
(1) diameter (inches) 4
(2) total depth (feet) 30
(3) static water level (feet) 11 below/above top of ground.
(4) casing PVC (material), 20 (depth),
4" (size) if telescope see back.
(5) screen 10' (length), 20' (depth to top)
.010 (size), PVC (material)
(6) pump 1/2 Sub. (HP) 8 (yield gpm)
electricity (type power)
(7) electric log no (yes or no)
(organization running log)
(8) how well bottom plugged
back wash valve

DRILLERS REMARKS:

description of formations encountered	from	to
Citronelle	1	30

DEPT. OF NATURAL RESOURCES
BUREAU OF LAND & WATER RESOURCES
JUN 5 - 1981
RECEIVED

If well telescopes please sketch and show depths.

GROUND LEVEL

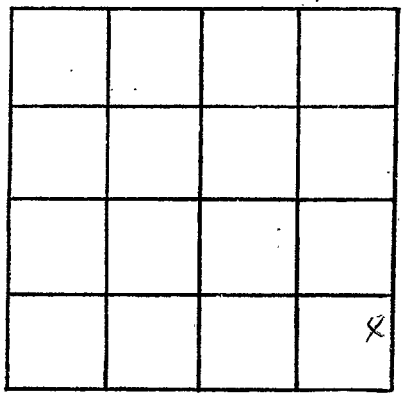

SECTION 24

Please indicate well location X.

ADDITIONAL INFORMATION

If more than one screen, show locations of each on sketch.