MISSISSIPPI DEPARTMENT OF NATURAL RESOURCES

Bureau of Land and Water Resources

P.O. Box 10631
Jackson, Mississippi 39209
WATER WELL DRILLERS LOG

COUNTY WELL LOCATED: LINCOLN

WELL NUMBER: K 20 | CODED: 73

DATE WELL COMPLETED: 10-4-88

PERMIT NUMBER:

NAME OF DRILLING FIRM: Glenn Water Well & Supply Inc.

NAME & MAILING ADDRESS OF LANDOWNER: McCall Creek Methodist Parsonage

McCall Creek, Ms.

WELL LOCATION: SEC 14 TOWNSHIP 6 (N) S RANGE 6 (E) W

DISTANCE: 10 Miles DIRECTION: SW NEAREST TOWN: Brookhaven

OTHER LANDMARK:

WELL PURPOSE: (Home), Irrigation, Municipal, Industrial, Fish Pond, etc.

PUMP DATA

PUMP TYPE (Circle One): Submersible, Turbine, Jet, Flowing Well, Other (Describe) did not install

POWER TYPE (Circle One): Electric, Tractor, Diesel, Gasoline, Butane, Other (Describe) _____ H/P _____

Pump Capacity (GPM)	No. of Stages	Setting Depth
		FT.

PUMP TEST

Well yielded 14 GPM with a drawdown of 0 ft. after 2 hours of pumping

WELL DATA

Well Depth	Casing Diameter (In.)	Casing Length (Ft.)
60	4	50

Type of Casing	Hole Depth	Depth to Static Water Level
PVC	70	37

TYPE OF COMPLETION: (Circle One or More): (Gravel Packed), Underreamed, Telescoped, Natural Development, Open Hole, Other (Describe) _____

Top of Lap Pipe or Reduction in Casing: FEET

IF TELESCOPED OR MORE THAN ONE SCREEN: USE BACK PAGE

SCREEN DATA

Diameter - Inches	Length - Feet	Slot Size - Inches
4	10	.010

Screen Type	Depth to Bottom - Feet
PVC	60

LOG DATA

TYPE OF LOG RUN (Circle One): (No Log Run), Electric, Gamma Ray, Density, Sonic, Neutron, Other (Describe) _____

Name of Organization Running Log:

GEOLOGIC DATA (Office Use Only)

Surface Elev.	Geologic Unit	Unit Thickness	Depth to Top
Subs. SWL	Date	Analysis	Aquifer Test

Driller's Remarks:

DESCRIPTION OF FORMATIONS ENCOUNTERED	FROM	TO
Citronelle	0	60
White Clay	60	70

FORMATIONS (Continued)	FROM	TO

IF MORE SPACE IS NEEDED, USE BACK

RECEIVED
FEB 9 1989
Department of Natural Resources
Bureau of Land & Water Resources

If well telescopes please
sketch and show depths.

GROUND LEVEL

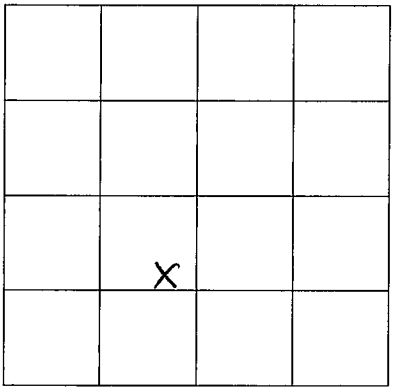

SECTION 14

Please indicate well location X.

ADDITIONAL INFORMATION

If more than one screen,
show location of each on sketch.