Lincoln
L7
10-25-68

CODED

MISSISSIPPI
BOARD OF WATER COMMISSIONERS
416 North State Street
Jackson, Mississippi 39201

WATER WELL DRILLERS LOG

10-25 19 68 Ft Gould well drl Lincoln
date well completed — firm name — county well located

LANDOWNER: J. H. Davis.

BR. Bogue Chitto Miss.
(mailing address)

WELL LOCATION:
sec. 25 T 6 N (S) R 7 E (W)

2 (distance) miles N (direction) of Bogue Chitto (nearest town)

WELL PURPOSE:
(home, irrigation, municipal, industrial)

WELL COMPLETION DATA:

(1) diameter (inches) 4

(2) total depth (feet) 182

(3) static water level (feet) 2" ~~below~~ above top of ground.

(4) casing Plastic (material), 176 (depth),
4 (size) if telescope see back.

(5) screen 6 (length), 176 (depth to top)
4 (size), Plastic (material)

(6) pump ? (HP) ? (yield gpm)
Ele (type power)

(7) electric log No (yes or no)
(organization running log)

(8) how well bottom plugged Wood plug

DRILLERS REMARKS:

description of formations encountered	from	to
top soil + Red clay	0	10
Fine Sand	10	14
Blue clay	14	130
Progressively coarser sand	130	182

NOV 20 1968
MISS. BOARD OF WATER COMMS.

If well telescopes please sketch and show depths.

GROUND LEVEL

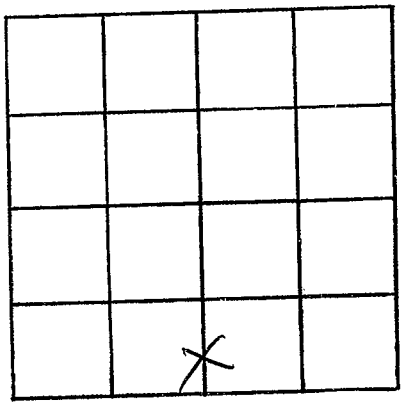

SECTION 25

Please indicate well location X.

ADDITIONAL INFORMATION

If more than one screen, show locations of each on sketch.