LINCOLN
M 203
6-27-80

MISSISSIPPI
BOARD OF WATER COMMISSIONERS
416 North State Street
Jackson, Mississippi 39201

WATER WELL DRILLERS LOG

June 27 19 80 Grenn Water Well Cont. Lincoln
date well completed — firm name — county well located

LANDOWNER: Kathy Furr
Route 4
Brookhaven, Ms.
(mailing address)

WELL LOCATION:
sec. 2 T 6 (N) S R 8 (E) W
5 (distance) miles SE (direction) of Brookhaven (nearest town)

WELL PURPOSE: home
(home, irrigation, municipal, industrial)

WELL COMPLETION DATA:

(1) diameter (inches) 4
(2) total depth (feet) 75
(3) static water level (feet) 33 below ~~above~~ top of ground.
(4) casing PVC (material), 65 (depth),
4" (size) if telescope see back.
(5) screen 10' (length), 65' (depth to top)
.010 (size), PVC (material)
(6) pump did not install (HP) (yield gpm)
(type power)
(7) electric log no (yes or no)
(organization running log)
(8) how well bottom plugged backwash valve

DRILLERS REMARKS:

description of formations encountered	from	to
Citronlle	1	75

DEPT. OF NATURAL RESOURCES
BUREAU OF LAND & WATER RESOURCES
AUG 18 1980
RECEIVED

If well telescopes please sketch and show depths.

GROUND LEVEL

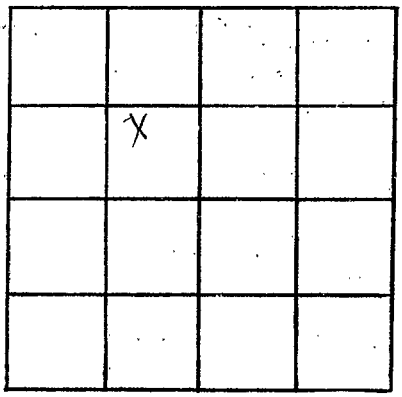

SECTION 2

Please indicate well location X.

ADDITIONAL INFORMATION

If more than one screen, show locations of each on sketch.