MISSISSIPPI DEPARTMENT OF NATURAL RESOURCES

Bureau of Land and Water Resources

P.O. Box 10631
Jackson, Mississippi 39209

WATER WELL DRILLERS LOG

COUNTY WELL LOCATED: Lincoln	
WELL NUMBER: M 2083	CODED:
DATE WELL COMPLETED: Sept 22-89	
PERMIT NUMBER:	
NAME OF DRILLING FIRM: Fitzgerald Well Serv	

NAME & MAILING ADDRESS OF LANDOWNER
Bruce Dean
R.R. Edwinton Ms.

WELL LOCATION: SEC 18 TOWNSHIP 6 N/S RANGE 8 E/W

DISTANCE 4 Miles DIRECTION SE of NEAREST TOWN Eddiceston

OTHER LANDMARK

WELL PURPOSE: Home, Irrigation, Municipal, Industrial, Fish Pond, etc.
Home

PUMP DATA

PUMP TYPE (Circle One): Submersible, Turbine, Jet, Flowing Well, Other (Describe)

POWER TYPE (Circle One): Electric, Tractor, Diesel, Gasoline, Butane, Other (Describe) H/P

Pump Capacity (GPM)	No. of Stages	Setting Depth
10	9	81 FT.

PUMP TEST

Well yielded 15 GPM with a drawdown of 1 ft. after 2 hours of pumping

WELL DATA

Well Depth	Casing Diameter (In.)	Casing Length (Ft.)
82	4	72

Type of Casing	Hole Depth	Depth to Static Water Level
PVC	82	76

TYPE OF COMPLETION: (Circle One or More): Gravel Packed, Underreamed, Telescoped, Natural Development, Open Hole, Other (Describe)

Top of Lap Pipe or Reduction in Casing FEET

IF TELESCOPED OR MORE THAN ONE SCREEN: USE BACK PAGE

LOG DATA

TYPE OF LOG RUN (Circle One): No Log Run, Electric, Gamma Ray, Density, Sonic, Neutron, Other (Describe)

Name of Organization Running Log

GEOLOGIC DATA (Office Use Only)

Surface Elev.	Geologic Unit	Unit Thickness	Depth to Top
Subs. SWL	Date	Analysis	Aquifer Test

Driller's Remarks

SCREEN DATA

Diameter - Inches	Length - Feet	Slot Size - Inches
4	10	1014

Screen Type	Depth to Bottom - Feet
PVC	82

DESCRIPTION OF FORMATIONS ENCOUNTERED	FROM	TO
Red Clay	0	20
Red Clay	20	70
Coarse Sand & gravel	70	82

FORMATIONS (Continued)	FROM	TO

RECEIVED
NOV 07 1989
Department of Natural Resources
Bureau of Land & Water Resources

IF MORE SPACE IS NEEDED, USE BACK

If well telescopes please
sketch and show depths.

GROUND LEVEL

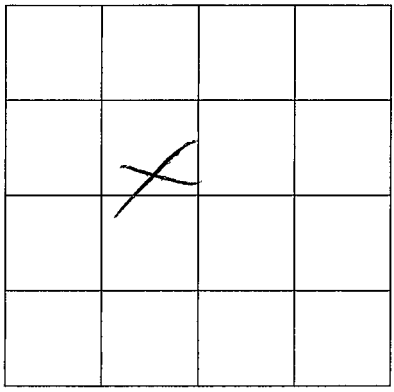

SECTION 18

Please indicate well location X.

ADDITIONAL INFORMATION

If more than one screen,
show location of each on sketch.