MISSISSIPPI DEPARTMENT OF ENVIRONMENTAL QUALITY
Office of Land and Water Resources

P. O. Box 10631
Jackson, MS 39289-0631

WATER WELL DRILLERS LOG

COUNTY WELL LOCATED	Lincoln
WELL NUMBER	M-2026
CODED	
DATE WELL COMPLETED	7-14-00
PERMIT NUMBER	
NAME OF DRILLING FIRM	Green Water Well Supply

NAME & MAILING ADDRESS OF LANDOWNER: Tommy Smith
Prudale Dr. SE
Bogue Chitto MS

WELL LOCATION — SEC: 18 TOWNSHIP: 6 (N) S RANGE: 8 (E) W

DISTANCE: 6 Miles DIRECTION: S NEAREST TOWN: of Brookhaven

OTHER LANDMARK:

WELL PURPOSE: (Home) Irrigation, Municipal, Industrial, Fish Pond, etc.

PUMP DATA

PUMP TYPE (Circle One): (Submersible) Turbine, Jet Flowing Well, Other (Describe)

POWER TYPE (Circle One): (Electric) Tractor, Diesel, Gasoline, L.P. Butane, Other (Describe) H/P ½

Pump Capacity (GPM)	No. of Stages	Setting Depth
10	9	80 FT.

PUMP TEST: Well yielded 10 GPM with a drawdown of 0 ft. after 1 hours of pumping

WELL DATA

Well Depth	Casing Diameter (In.)	Casing Length (Ft.)
230	4 in.	220

Type of Casing	Hole Depth	Depth to Static Water Level
PVC	245	60

TYPE OF COMPLETION: (Circle One or More): (Gravel Packed) Underreamed, Telescoped, Natural Development, Open Hole, Other (Describe)

WELL GROUTED TO A DEPTH OF 10 FEET
Type Grout (circle one): Cement, Bentonite, or (Mix)

LOG DATA

TYPE OF LOG RUN (Circle One): (No Log Run) Electric, Gamma Ray, Density, Sonic, Neutron, Other (Describe)

Name of Organization Running Log

GEOLOGIC DATA (Office Use Only)

Surface Elev	Geologic Unit	Unit Thickness	Depth to Top
Sub's SWL	Date	Analysis	Aquifer Test

Driller's Remarks

SCREEN DATA

Diameter - Inches	Length - Feet	Slot Size - Inches
4	10	.010

Screen Type	Depth to Bottom - Feet
PVC	230

Top of Lap Pipe or Reduction in Casing FEET

IF TELESCOPED OR MORE THAN ONE SCREEN: USE BACK PAGE

DESCRIPTION OF FORMATIONS ENCOUNTERED	FROM	TO
Red Clay	0	35
Sand & Gravel	35	69
White Clay	69	90
Blue Clay	90	205
Sand	205	245

FORMATIONS (Continued)	FROM	TO

IF MORE SPACE IS NEEDED, USE BACK

If well telescopes please sketch and show depths.

GROUND LEVEL

 

If more than one screen, show location of each on sketch.

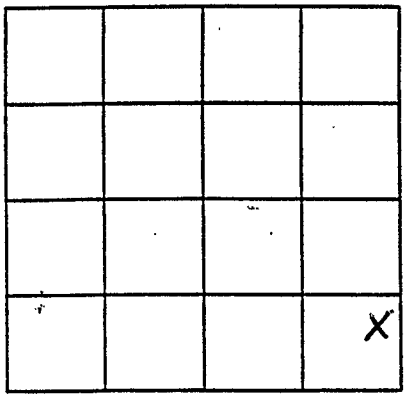

SECTION 18

Please indicate well location X.

ADDITIONAL INFORMATION