MISSISSIPPI DEPARTMENT OF ENVIRONMENTAL QUALITY
Office of Land and Water Resources

P. O. Box 10631
Jackson, MS 39289-0631

WATER WELL DRILLERS LOG

COUNTY WELL LOCATED: Lincoln	
WELL NUMBER: M-2130	CODED:
DATE WELL COMPLETED: 12-5-00	
PERMIT NUMBER: Gremm Water Well & Supply	
NAME OF DRILLING FIRM: Dale Dr. SE, Bogue Chitto, MS 39629	

NAME & MAILING ADDRESS OF LANDOWNER
Buddy Rials
2033 Hunters Rd SE
Bogue Chitto MS

WELL LOCATION	SEC	TOWNSHIP	RANGE
	23	6 (N) S	8 (E) W

DISTANCE	DIRECTION	NEAREST TOWN
1 Miles	East	of Enterprise

OTHER LANDMARK

WELL PURPOSE: Home, Irrigation, Municipal, Industrial, Fish Pond, etc.

PUMP DATA

PUMP TYPE (Circle One): Submersible, Turbine, Jet, Flowing Well, Other (Describe) ____

POWER TYPE (Circle One): Electric, Tractor, Diesel, Gasoline, Butane, Other (Describe) ____ H/P ____

Pump Capacity (GPM)	No. of Stages	Setting Depth
		FT.

PUMP TEST

Well yielded ____ GPM with a drawdown of ____ ft. after ____ hours of pumping

WELL DATA

Well Depth	Casing Diameter (In.)	Casing Length (Ft.)
90	4	70

Type of Casing	Hole Depth	Depth to Static Water Level
PVC	98	45

TYPE OF COMPLETION: (Circle One or More): Gravel Packed, Underreamed, Telescoped, Natural Development, Open Hole, Other (Describe) ____

WELL GROUTED TO A DEPTH OF 10 FEET
Type Grout (circle one): Cement, Bentonite, or Mix

LOG DATA

TYPE OF LOG RUN (Circle One): No Log Run; Electric, Gamma Ray, Density, Sonic, Neutron, Other (Describe) ____

Name of Organization Running Log

GEOLOGIC DATA (Office Use Only)

Surface Elev	Geologic Unit	Unit Thickness	Depth to Top
Subs SWL	Date	Analysis	Aquifer Test

Driller's Remarks

SCREEN DATA

Diameter - Inches	Length - Feet	Slot Size - Inches
4	20	1010

Screen Type	Depth to Bottom - Feet
PVC	90

Top of Lap Pipe or Reduction in Casing: FEET

IF TELESCOPED OR MORE THAN ONE SCREEN: USE BACK PAGE

DESCRIPTION OF FORMATIONS ENCOUNTERED	FROM	TO
Red Clay	0	17
Sand & Gravel	17	90
White Clay	90	98

FORMATIONS (Continued)	FROM	TO

IF MORE SPACE IS NEEDED, USE BACK

RECEIVED
MAR 1 0 2001
Dept. of Environmental Quality
Office of Land & Water Resources

If well telescopes please sketch and show depths.

GROUND LEVEL

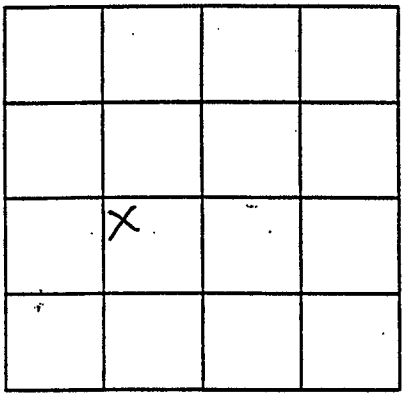

SECTION 23

Please indicate well location X.

ADDITIONAL INFORMATION

If more than one screen, show location of each on sketch.