LINCOLN

N

04-06-79

2019

MISSISSIPPI
BOARD OF WATER COMMISSIONERS
416 North State Street
Jackson, Mississippi 39201

WATER WELL DRILLERS LOG

Lincoln

April 6 19 79 Grenn Water Well XXXXXXXXXX
date well completed — firm name — county well located

LANDOWNER: Dennis Case

Route 4

Brookhaven, Ms. 39601
(mailing address)

WELL LOCATION:
sec. 11 T 6 N/S R 9 E/W

8 (distance) miles E (direction) of Brookhaven (nearest town)

WELL PURPOSE: home
(home, irrigation, municipal, industrial)

WELL COMPLETION DATA:

(1) diameter (inches) 4

(2) total depth (feet) 100

(3) static water level (feet) 50 below/above top of ground.

(4) casing PVC (material), 88 (depth),
4" (size) if telescope see back.

(5) screen 12' (length), 88' (depth to top)
.010 (size), PVC (material)

(6) pump 1/2 (HP) sub 10 (yield gpm)
electricity (type power)

(7) electric log no (yes or no)

(organization running log)

(8) how well bottom plugged backwash valve

DRILLERS REMARKS:

description of formations encountered	from	to
Citronelle	1	100

Miss. Board of Water Comm.

MAY -9 1979

RECEIVED

If well telescopes please sketch and show depths.

GROUND LEVEL

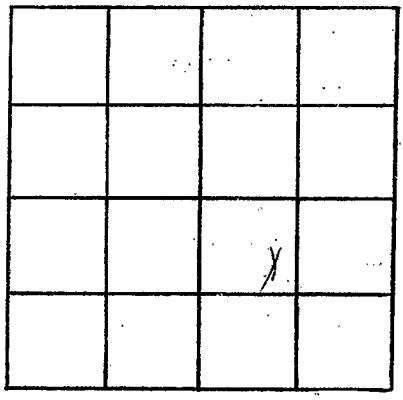

SECTION 11

Please indicate well location X.

ADDITIONAL INFORMATION

If more than one screen, show locations of each on sketch.