LINCOLN

N

7/04/79

2022

MISSISSIPPI
BOARD OF WATER COMMISSIONERS
416 North State Street
Jackson, Mississippi 39201

WATER WELL DRILLERS LOG

July 4 19 79 Grenn Water Well Cont. Lincoln

date well completed — firm name — county well located

LANDOWNER: Ernestine Conn

Route 4, Box 247

Brookhaven, Miss.
(mailing address)

WELL LOCATION:

sec. 17 T 6 N/S R 9 E/W

7 (distance) miles SE (direction) of Brookhaven (nearest town)

WELL PURPOSE: Home
(home, irrigation, municipal, industrial)

WELL COMPLETION DATA:

(1) diameter (inches) 4

(2) total depth (feet) 70

(3) static water level (feet) 50 below ~~above~~ top of ground.

(4) casing PVC (material), 58' (depth),

4" (size) if telescope see back.

(5) screen 12' (length), 58' (depth to top)

.010 (size), PVC (material)

(6) pump did not install (HP) (yield gpm)

(type power)

(7) electric log no (yes or no)

(organization running log)

(8) how well bottom plugged back wash valve

DRILLERS REMARKS:

description of formations encountered	from	to
Citronelle	1	70

Miss. Board of Water Comm.
AUG 16 1979
RECEIVED

If well telescopes please sketch and show depths.

GROUND LEVEL

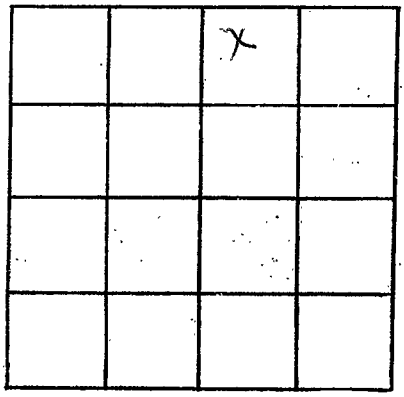

SECTION 17

Please indicate well location X.

ADDITIONAL INFORMATION

If more than one screen, show locations of each on sketch.