Lincoln
015
7-10-69

MISSISSIPPI
BOARD OF WATER COMMISSIONERS
416 North State Street
Jackson, Mississippi 39201

CODED

WATER WELL DRILLERS LOG

July 10 1969 Felves well drilling Co. Lincoln
date well completed — firm name — county well located

LANDOWNER: Lal Lewis
R.F.D. McCall Creek
(mailing address)

WELL LOCATION:
sec. 17 T. 5 N R. 6 E
3 miles N-New Auburn
(distance) (direction) (nearest town)

WELL PURPOSE: Home
(home, irrigation, municipal, industrial)

WELL COMPLETION DATA:
(1) diameter (inches) 4"
(2) total depth (feet) 87
(3) static water level (feet) 62 below ~~above~~ top of ground.
(4) casing Plastic Bottom
(material) (depth)
_____ (size) if telescope see back.
(5) screen 6' 81'
(length) (depth to top)
4" Plastic
(size) (material)
(6) pump No pump 7
(HP) (yield gpm)
over 6 mile Feb.
(type power)
(7) electric log No
(yes or no)
(organization running log)
(8) how well bottom plugged
wood plug

DRILLERS REMARKS:

description of formations encountered	from	to
Clay	0	22
Red sand	22	67
Chalk & gravel	67	70
Fine Sand	70	80
Gravel & Sand	80	87

SEP 18 1969
MISS. BD. OF WATER COMM.

If well telescopes please sketch and show depths.

GROUND LEVEL

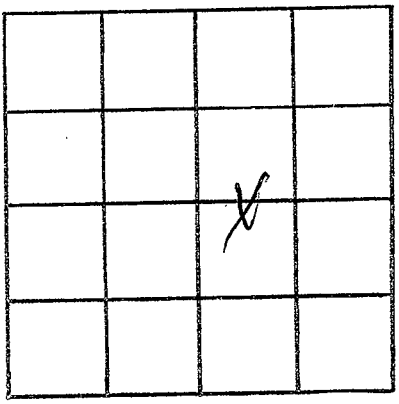

SECTION 17

Please indicate well location X.

ADDITIONAL INFORMATION

If more than one screen, show locations of each on sketch.