[redacted] Lincoln

Lincoln

[redacted]

Φ 17

5-5-70

3 DA

MISSISSIPPI
BOARD OF WATER COMMISSIONERS
416 North State Street
Jackson, Mississippi 39201

VOIDED

[redacted]

WATER WELL DRILLERS LOG

5 May 1970 A.T. Covington & Son [redacted]

date well completed — firm name — county well located

LANDOWNER: Roger Whittington

Smithdale

(mailing address)

WELL LOCATION: 168

sec. 20 T 5 N (S) R 6 E (W)

10 (distance) miles West (direction) of Summit (nearest town)

WELL PURPOSE: Home (home, irrigation, municipal, industrial)

WELL COMPLETION DATA:

(1) diameter (inches) 4

(2) total depth (feet) 85

(3) static water level (feet) 45 below above top of ground.

(4) casing Pl (material), 79 (depth),

4" (size) if telescope see back.

(5) screen 6' (length), 79 (depth to top)

4 (size), Pl (material)

(6) pump 5 (HP) 10 (yield gpm)

Elect (type power)

(7) electric log _____ (yes or no)

_____ (organization running log)

(8) how well bottom plugged wood

DRILLERS REMARKS:

description of formations encountered	from	to
Clay	0	10
Clay Rock	10	20
Sand	20	30
Chalk Sand	30	40
Sand Rock	40	85

JUN 5 1970

MISS. BD. OF WATER COMM.

If well telescopes please sketch and show depths.

GROUND LEVEL

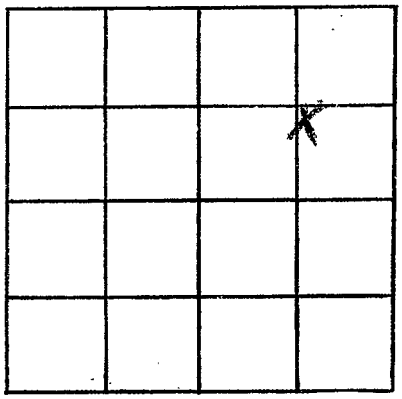

SECTION 20

Please indicate well location X.

ADDITIONAL INFORMATION

If more than one screen, show locations of each on sketch.