MISSISSIPPI DEPARTMENT OF ENVIRONMENTAL QUALITY
Office of Land and Water Resources

P. O. Box 10631
Jackson, MS 39289-0631
WATER WELL DRILLERS LOG

COUNTY WELL LOCATED: Lincoln	PERMIT NUMBER: O-621
WELL NUMBER: 2070 (CODED)	NAME OF DRILLING FIRM: Daniel Boone
DATE WELL COMPLETED: 6-16-98	

NAME & MAILING ADDRESS OF LANDOWNER
Christy McClendon
1921 Brumfield Rd.
Summit MS

WELL LOCATION: SEC 34 TOWNSHIP 5 (N) S RANGE 6 (E) W

DISTANCE 10 Miles DIRECTION W of NEAREST TOWN McComb

OTHER LANDMARK

WELL PURPOSE: (Home), Irrigation, Municipal, Industrial, Fish Pond, etc.

PUMP DATA

PUMP TYPE (Circle One): (Submersible), Turbine, Jet, Flowing Well, Other (Describe)

POWER TYPE (Circle One): (Electric), Tractor, Diesel, Gasoline, Butane, Other (Describe) H/P 3/4

Pump Capacity (GPM)	No. of Stages	Setting Depth
8		80 FT.

PUMP TEST

Well yielded 12 GPM with a drawdown of 20 ft. after 10 hours of pumping

WELL DATA

Well Depth	Casing Diameter (In.)	Casing Length (Ft.)
90	4"	80'

Type of Casing	Hole Depth	Depth to Static Water Level
PVC	91	45'

TYPE OF COMPLETION: (Circle One or More): (Gravel Packed), Underreamed, Telescoped, Natural Development, Open Hole, Other (Describe)

WELL GROUTED TO A DEPTH OF 10 FEET
Type Grout (circle one): (Cement), Bentonite, or Mix

LOG DATA

TYPE OF LOG RUN (Circle One): (No Log Run), Electric, Gamma Ray, Density, Sonic, Neutron, Other (Describe)

Name of Organization Running Log

GEOLOGIC DATA (Office Use Only)

Surface Elev.	Geologic Unit	Unit Thickness	Depth to Top
Subs. SWL	Date	Analysis	Aquifer Test

Driller's Remarks

SCREEN DATA

Diameter - Inches	Length - Feet	Slot Size - Inches
4"	10'	.010

Screen Type	Depth to Bottom - Feet
PVC Sch. 40	1'

07 28 99 01:50 RCVD

Top of Lap Pipe or Reduction in Casing FEET

IF TELESCOPED OR MORE THAN ONE SCREEN: USE BACK PAGE

DESCRIPTION OF FORMATIONS ENCOUNTERED	FROM	TO	FORMATIONS (Continued)	FROM	TO
Clay	0	25			
Pea Gravel	25	45			
Sand	45	70			
Pea Gravel	70	90			
			IF MORE SPACE IS NEEDED, USE BACK		

If well telescopes please
sketch and show depths.

GROUND LEVEL

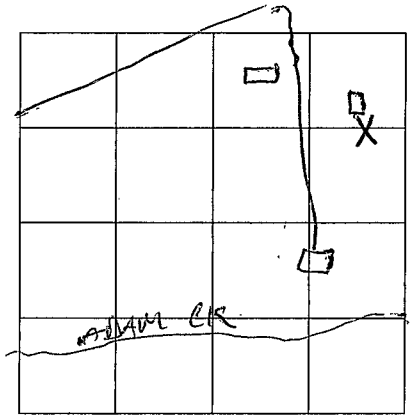

SECTION 34

Please indicate well location X.

ADDITIONAL INFORMATION

If more than one screen,
show location of each on sketch.